

MAY 22 2000

\$7.00
\$2.00

SECTION LAND CORNER RECORDATION CERTIFICATE
Filing Requirement of Act 74, Mich. P.A. 1970
KENT COUNTY REMONUMENTATION

For corners in

Kent (County)	Located in:	Oakfield Township	Corner Code #
1. Public Land Survey	T <u>9N</u>	R <u>9W</u>	<u>D-4</u>
	T _____	R _____	_____
	T _____	R _____	_____
	T _____	R _____	_____
2. Property Controlling in Section	S _____	T _____	R _____
	S _____	T _____	R _____
3. Miscellaneous Property in Sec.	S _____	T _____	R _____
	S _____	T _____	R _____

REG. OF DEEDS

[Signature]

STATE OF MICHIGAN
COUNTY OF KENT
RECEIVED FOR RECORD
1999 DEC 27 AM 8:18


11633

Register of Deeds Stamp & File Number

- 4. Lot No. _____, Recorded Plat _____
- 5. Private Claims _____

I, Randy Kolehouse, in a field survey on December 16 19 99, do hereby certify that under requirements of P.A. 74 Michigan P.A. of 1970, the corner points mentioned in lines 1 and 2 above were in conformance with regulations and rules therefore as required in the current manual of survey instructions of the United States Department of the interior, Bureau of Land Management or by a decree of a Court of Law and/or that the corner points mentioned in lines 3, 4 and 5 above were in conformance with the rules of the Michigan Board of Land Surveyors or by a Decree of a Court of Law; established, re-established, monumented, re-monumented, recovered, found as expressed below:

NOTE: Not more than 4 corners, all in the same town and range, may be recorded on this certificate.

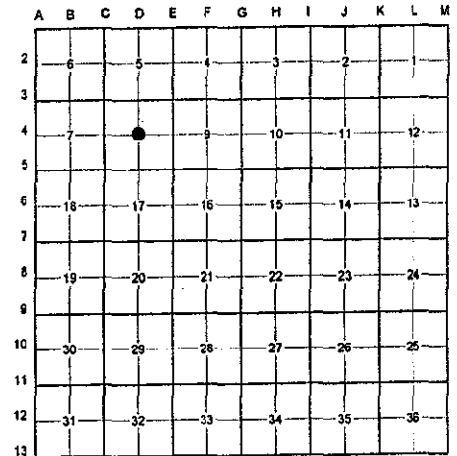

A. Description of original monument and accessories and/or subsequent restoration:

D-4 This corner was not originally set by the G.L.O.

1983	Survey Records	G. Hackbart	Iron
N/A	White Pines Condo	JCK	Iron
1997	Crawford Lake Nature Est.	Nederveld & Assoc.	N/A

P.A. 345 1990 KENT COUNTY
PEER APPROVED 12/2/99
CHAIRMAN [Signature]

B. Description of corner evidence found and/or method applied in restoring or reestablishing corner:


D-4 Found a 1/2" rebar on the line of occupation running West and South. Said rebar checks surveys by Glen Hackbart and JCK Surveying. The found rebar is 0.2' North and 0.2' West of the intersection of 1/4 lines. Held the found rebar as the Center of Section.

The selected location is accepted by me and is generally accepted by professional surveyors as the best available evidence of the position of the original corner.

C. Description of monument for corner and accessories established to perpetuate locating the position of the corner:

D-4 Replaced 1/2" Rebar with a Standard Kent County Monument

- Nail & K.C. remon. tag on N side 8" Oak S 75° E 12.08'
- Nail & K.C. remon. tag on NE side 6" Oak S 10° E 15.23'
- Nail & K.C. remon. tag on N side 6" Oak N 75° W 2.89'
- Nail & K.C. remon. tag on E side 8" Oak N 05° W 10.48'
- Nail & K.C. remon. tag on NW side 12" Oak N 60° E 42.24'

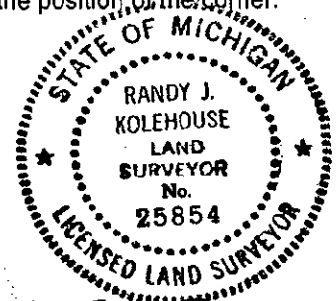

Signed by Randy J. Kolehouse Date 12-20-99

WILLIAMS & WORKS

Surveyor's Michigan License No. 25854