

**SURVEY &
REMONUMENTATION**

~~\$7.00~~
\$2.00

MAY 22 2000

SECTION LAND CORNER RECORDATION CERTIFICATE
Filing Requirement of Act 74, Mich. P.A. 1970
KENT COUNTY REMONUMENTATION

For corners in

Kent (County)	Located in: Oakfield Township	Corner Code #
1. Public Land Survey	T <u>9N</u> R <u>9W</u>	<u>D-5</u>
	T _____ R _____	_____
	T _____ R _____	_____
	T _____ R _____	_____
2. Property Controlling in Section	S _____ T _____ R _____	_____
	S _____ T _____ R _____	_____
3. Miscellaneous Property in Sec.	S _____ T _____ R _____	_____
	S _____ T _____ R _____	_____

REG. OF DEEDS

[Signature]


STATE OF MICHIGAN
COUNTY OF KENT
RECEIVED FOR RECORD
1999 DEC - 8 AM 10:06

11544

Register of Deeds Stamp & File Number

4. Lot No. _____, Recorded Plat _____
5. Private Claims _____

I, Randy Kolehouse, in a field survey on October 14 19 99, do hereby certify that under requirements of P.A. 74 Michigan P.A. of 1970, the corner points mentioned in lines 1 and 2 above were in conformance with regulations and rules therefore as required in the current manual of survey instructions of the United States Department of the Interior, Bureau of Land Management or by a decree of a Court of Law and/or that the corner points mentioned in lines 3, 4 and 5 above were in conformance with the rules of the Michigan Board of Land Surveyors or by a Decree of a Court of Law; established, re-established, monumented, re-monumented, recovered, found as expressed below:

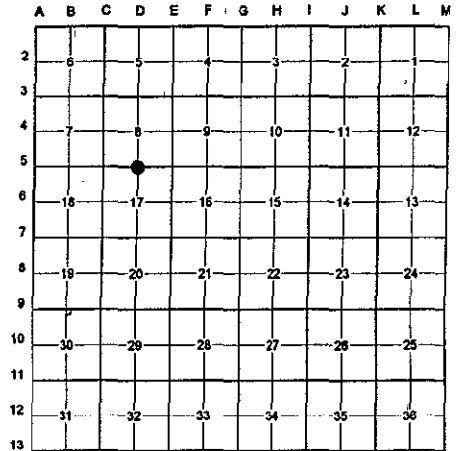

NOTE: Not more than 4 corners, all in the same town and range, may be recorded on this certificate.

A. Description of original monument and accessories and/or subsequent restoration:

D-5	1837	G.L.O. Notes	Cathcart	Set Post
	1963	Witness Map	K.C. Surveyor	Monument
	1974	L.C.R.C. #659	F.E. Spicer	1/2" Iron in Mon. Box
	1981	L.C.R.C. #1669	Williams & Works	Fnd. 1/2" Iron in Mon. Box / Set K.C. Mon. in Mon. Box
	1989	L.C.R.C. #5188	John Bueche	K.C. Monument in Mon. Box
	1997	L.C.R.C. #9650	Kirk Breitels	K.C. Monument

P.A. 345 1990 KENT COUNTY
PEER APPROVED 10/28/99
CHAIRMAN [Signature]

This corner was originally approved by the Kent County Remonumentation Peer Group and monumented by Williams & Works on 4/15/81 and was recorded per L.C.R.C. #1669.

B. Description of corner evidence found and/or method applied in restoring or reestablishing corner:

D-5 Found a Standard Kent County Monument 1.5' South of the C/L of 14 Mile Road (bit.) running East and West, on line of a tree row running North, per L.C.R.C.'s #1669, #5188, and #9650 as set by Williams & Works in place of a 1/2" iron they found in a monument box which checked L.C.R.C. #659 and the K.C. Surveyor's records.

L.C.R.C. #1669

L.C.R.C. #9650

K.C. Remon. tag and nail in W side Power Pole N 75.59'
K.C. Remon. tag and nail in W side service pole S 30°E. 86.51'
SE cor. block bldg. N15°W. 134.10'
NE cor. frame bldg. S20°W. 70.67'
NW cor. frame bldg. S60°W. 91.46'


Nail & KC Remon. tag W. side P. Pole N15°W 75.73' (m. 75.70')
Nail & KC Remon. tag W. side Serv. Pole S30°E 86.44' (m. 86.35')
SE corner bldg. Siding N25°W 121.34'
NE corner frame bldg. S20°W 70.60'
NW corner frame bldg. S60°W 91.46' (m. 91.41')
C/L 14 Mile Rd. E-W is 1.5' North +/-

The selected location is accepted by me and is generally accepted by professional surveyors as the best available evidence of the position of the original corner.

C. Description of monument for corner and accessories established to perpetuate locating the position of the corner:

D-5 Standard Kent County Monument

Nail & K.C. remon. tag on W side P. pole N 15° W 75.30'
Nail & K.C. remon. tag on W side Service pole S 30° E 86.35'
SE cor. bldg. Siding N 25° W 121.34'
NE cor. frame bldg. S 20° W 70.60'
NW cor. frame bldg. S 60° W 91.41'
C/L of bit. road running E-W, North 1.5'
On tree row running N

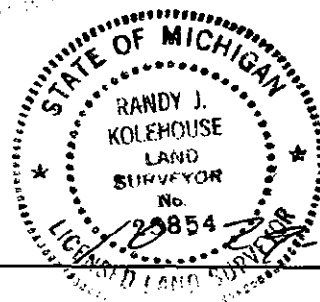

Signed by Randy J. Kolehouse Date _____

WILLIAMS & WORKS

Surveyor's Michigan License No. 25854