

MAY 22 2000

\$7.00
\$2.00

SECTION LAND CORNER RECORDATION CERTIFICATE
Filing Requirement of Act 74, Mich. P.A. 1970
KENT COUNTY REMONUMENTATION

STATE OF MICHIGAN
COUNTY OF KENT
RECEIVED FOR RECORD
1999 OCT 27 AM 8:37

REG. OF DEEDS
[Signature]

For corners in

Kent (County)	Located in: Oakfield Township	Corner Code #
1. Public Land Survey	T <u>9N</u> R <u>9W</u>	<u>D-9</u>
	T _____ R _____	_____
	T _____ R _____	_____
	T _____ R _____	_____
2. Property Controlling in Section	S _____ T _____ R _____	_____
	S _____ T _____ R _____	_____
3. Miscellaneous Property in Sec.	S _____ T _____ R _____	_____
	S _____ T _____ R _____	_____


11418

Register of Deeds Stamp & File Number

- 4. Lot No. _____, Recorded Plat _____
- 5. Private Claims _____

I, Randy Kolehouse, in a field survey on March 17 19 99, do hereby certify that under requirements of P.A. 74 Michigan P.A. of 1970, the corner points mentioned in lines 1 and 2 above were in conformance with regulations and rules therefore as required in the current manual of survey instructions of the United States Department of the interior, Bureau of Land Management or by a decree of a Court of Law and/or that the corner points mentioned in lines 3, 4 and 5 above were in conformance with the rules of the Michigan Board of Land Surveyors or by a Decree of a Court of Law; established, re-established, monumented, re-monumented, recovered, found as expressed below:

NOTE: Not more than 4 corners, all in the same town and range, may be recorded on this certificate.

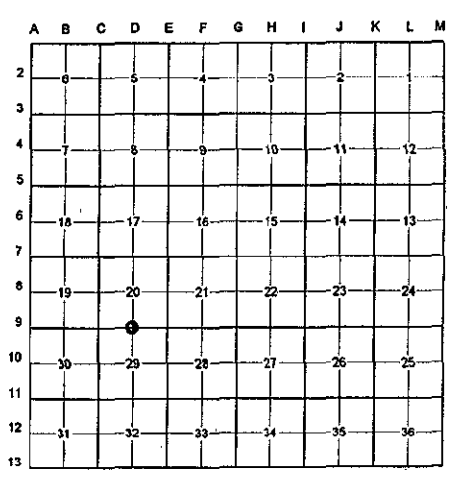

A. Description of original monument and accessories and/or subsequent restoration:

Date	Description	Monument	Accessories
D-9 1837	G.L.O. Notes	Cathcart	Set Post
1935	Witness Map	K.C. Surveyor	1" Iron
1983	L.C.R.C. #3569	William Byl	Fnd. 1" Iron / Set K.C. Monument
1989	L.C.R.C. #5190	John Bueche	K.C. Monument
1997	L.C.R.C. #9652	Kirk Breitels	K.C. Monument

P.A. 345 1990 KENT COUNTY
PEER APPROVED 7/29/99
CHAIRMAN [Signature]

This corner was originally approved by the Kent County Remonumentation Peer Group and monumented by William Byl on 8/30/83 and was recorded per L.C.R.C. #3569.

B. Description of corner evidence found and/or method applied in restoring or reestablishing corner:

D-9 Found a Standard Kent County Monument surrounded by a ring of stones 100' ± South of the C/L of 12 Mile Road (bit.) running East and West under 0.5' ± water per L.C.R.C.'s #3569, #5190, and #9652 as set by William Byl in place of a 1" iron pipe he found which checked the K.C. Surveyor's records.

L.C.R.C. #3569

L.C.R.C. #9652

- Nail & tag, S sd. 12" Triple Maple N 80° W 87.95'
- Nail & tag, N sd. 6" Cherry N 90° W 70.65'
- Nail & tag, E sd. 16" Maple S 05° W 93.05'
- Nail & tag, W sd. 12" Twin Maple S 35° W 53.00'


- Nail & KC Remon. tag S. side 16" Tri. Maple N80°W 87.95' (m. 87.92')
- Nail & KC Remon. tag N. side 7" Cherry N90°W 70.65'
- Nail & KC Remon. tag E. side 18" Maple S05°W 93.05' (m. 93.03')
- Nail & KC Remon. tag W. side 16" Tw. Maple S35°W 53.00' (m. 53.02')
- Corner is 125'+/- W. of Hse. #10805 & 100'+/- S. of road

The selected location is accepted by me and is generally accepted by professional surveyors as the best available evidence of the position of the original corner.

C. Description of monument for corner and accessories established to perpetuate locating the position of the corner:

D-9 Standard Kent County Monument

- Nail & K.C. remon. tag on S side 16" triple Maple N 80° W 87.92'
- Nail & K.C. remon. tag on N side 7" Cherry N 90° W 70.65'
- Nail & K.C. remon. tag on E side 18" Maple S 05° W 93.03'
- Nail & K.C. remon. tag on W side 16" twin maple S 35° W 53.02'
- Nail & K.C. remon. tag on NE side 12" Oak S 20° E 54.15'
- C/L of bit. road running E-W, North 100'

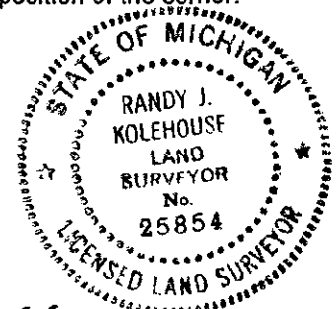

Signed by Randy J. Kolehouse
WILLIAMS & WORKS

Date 10-11-99

Surveyor's Michigan License No. 25854