

87.00
82.00

MAY 22 2000

LAND CORNER RECORDATION CERTIFICATE
Filing Requirement of Act 74, Mich. P.A. 1970
KENT COUNTY REMONUMENTATION

For corners in SECTION

Kent (County)	Located in: Oakfield Township	Corner Code #
1. Public Land Survey	T <u>9N</u> R <u>9W</u>	<u>D-11</u>
	T _____ R _____	_____
	T _____ R _____	_____
	T _____ R _____	_____
2. Property Controlling in Section	S _____ T _____ R _____	_____
	S _____ T _____ R _____	_____
3. Miscellaneous Property in Sec.	S _____ T _____ R _____	_____
	S _____ T _____ R _____	_____

REG. OF DEEDS

[Handwritten Signature]

STATE OF MICHIGAN
COUNTY OF KENT
RECEIVED FOR RECORD
1999 OCT 27 AM 8:37


11419

Register of Deeds Stamp & File Number

4. Lot No. _____, Recorded Plat _____
5. Private Claims _____

I, Randy Kolehouse, in a field survey on March 12 19 99, do hereby certify that under requirements of P.A. 74 Michigan P.A. of 1970, the corner points mentioned in lines 1 and 2 above were in conformance with regulations and rules therefore as required in the current manual of survey instructions of the United States Department of the interior, Bureau of Land Management or by a decree of a Court of Law and/or that the corner points mentioned in lines 3, 4 and 5 above were in conformance with the rules of the Michigan Board of Land Surveyors or by a Decree of a Court of Law; established, re-established, monumented, re-monumented, recovered, found as expressed below:

NOTE: Not more than 4 corners, all in the same town and range, may be recorded on this certificate.

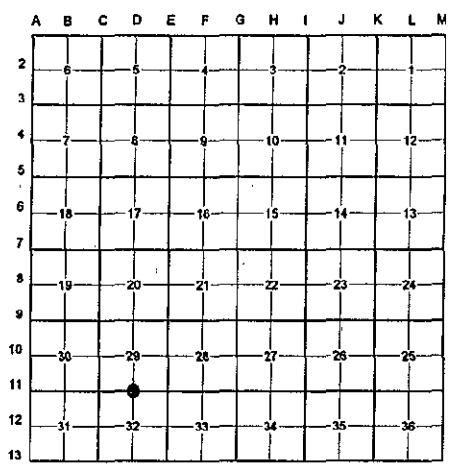

A. Description of original monument and accessories and/or subsequent restoration:

D-11	1837	G.L.O. Notes	Cathcart	Set Post
	1950	Witness Map	K.C. Surveyor	2" Iron
	1981	L.C.R.C. #1681	Williams & Works	Fnd. 2-1/2" Iron - Set K.C. Monument
	1989	L.C.R.C. #5191	John Bueche	K.C. Monument
	1997	L.C.R.C. #9654	Kirk Breitels	K.C. Monument

P.A. 345 1990 KENT COUNTY
PEER APPROVED 7/29/99
CHAIRMAN [Signature]

This corner was originally approved by the Kent County Remonumentation Peer Group and monumented by Williams & Works on 4/13/81 and was recorded per L.C.R.C. #1681.

B. Description of corner evidence found and/or method applied in restoring or reestablishing corner:

D-11 Found a Standard Kent County Monument 2' ± North of the C/L of 11 Mile Road (gravel) running East and West, on a tree row running North and South, and 17' ± West of a fence line running North, per L.C.R.C.'s #1681, #5191, and #9654 as set by Williams & Works in place of a 2-1/2" x 30" iron they found which checked the K.C. Surveyor's records.

L.C.R.C. #1681

L.C.R.C. #9654

- K.C. Remon. tag and nail in E. side 12" Poplar S.10°W. 49.31'
- K.C. Remon. tag and nail in SW side 14" Poplar S.45°E. 39.86'
- K.C. Remon. tag and nail in W dbl 12" Oak N.10°W. 19.90'
- K.C. Remon. tag and nail in S side 30" Oak East 140.10'

- Nail & KC Remon. tag E. side 16" Stump S10°W 39.88' (m. 39.85')
- Nail & KC Remon. tag W. side dbl. 20" Oak N10°W 19.85' (m. 19.99')
- Nail & KC Remon. tag S. side 40" Oak East 139.79' (m. 139.77')
- Nail & KC Remon. tag S. side 18" Oak N70°W 55.13' (m. 55.10')
- NE corner house (siding) S35°W 95.00' (m. 89.28')
- Nail & KC Remon. tag E. side 20" Poplar S05°E 48.76' (m. 48.70')
- Nail & KC Remon. tag N. side 15" Poplar S55°E 52.12' (m. 52.13')

The selected location is accepted by me and is generally accepted by professional surveyors as the best available evidence of the position of the original corner.

C. Description of monument for corner and accessories established to perpetuate locating the position of the corner:

D-11 Standard Kent County Monument

- Nail & K.C. remon. tag on E side 16" stump S 10° W 39.85'
- Nail & K.C. remon. tag on W side dbl. 20" Oak N 10° W 19.99'
- Nail & K.C. remon. tag on S side 40" Oak East 139.77'
- Nail & K.C. remon. tag on S side 18" Oak N 70° W 55.10'
- Nail & K.C. remon. tag on E side 20" Poplar S 05° E 48.70'
- Nail & K.C. remon. tag on N side 15" Poplar S 55° E 52.13'
- NE cor. hse. siding S 35° W 89.28'

- C/L of gravel road running E-W, South 2' ±
- On tree row running N-S
- Fence line running N, East 17' ±

Signed by Randy J. Kolehouse Date 10-11-99
WILLIAMS & WORKS

Surveyor's Michigan License No. 25854

