

MAY 22 2000

\$7.00
\$2.00

SECTION LAND CORNER RECORDATION CERTIFICATE
Filing Requirement of Act 74, Mich. P.A. 1970
KENT COUNTY REMONUMENTATION

For corners in

Kent (County)	Located in:	Oakfield Township	Corner Code #
1. Public Land Survey	T <u>9N</u>	R <u>9W</u>	<u>D-12</u>
	T _____	R _____	_____
	T _____	R _____	_____
	T _____	R _____	_____
2. Property Controlling in Section	S _____	T _____	R _____
	S _____	T _____	R _____
3. Miscellaneous Property in Sec.	S _____	T _____	R _____
	S _____	T _____	R _____

REG. OF DEEDS

[Signature]

STATE OF MICHIGAN
 COUNTY OF KENT
 RECEIVED FOR RECORD
 1999 DEC 27 AM 8:18

11636

Register of Deeds Stamp & File Number

4. Lot No. _____, Recorded Plat _____
 5. Private Claims _____


I, Randy Kolehouse, in a field survey on June 21 19 99, do hereby certify that under requirements of P.A. 74 Michigan P.A. of 1970, the corner points mentioned in lines 1 and 2 above were in conformance with regulations and rules therefore as required in the current manual of survey instructions of the United States Department of the interior, Bureau of Land Management or by a decree of a Court of Law and/or that the corner points mentioned in lines 3, 4 and 5 above were in conformance with the rules of the Michigan Board of Land Surveyors or by a Decree of a Court of Law; established, re-established, monumented, re-monumented, recovered, found as expressed below:

NOTE: Not more than 4 corners, all in the same town and range, may be recorded on this certificate.

A. Description of original monument and accessories and/or subsequent restoration:

D-12 This corner was not originally set by the G.L.O.

1995	Survey Records	Roosien	Iron
N/A	Survey Records	All-Points	N/A
N/A	Survey Records	Exxel Engineering	N/A

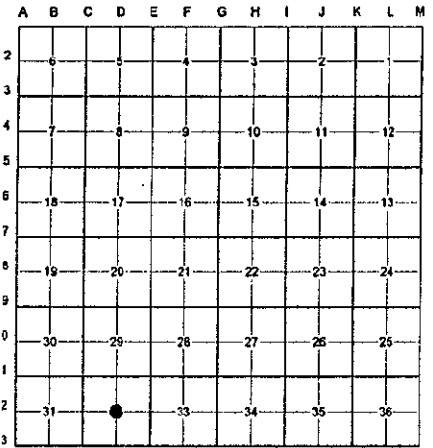

P.A. 345 1990 KENT COUNTY
 PEER APPROVED 6/29/99
 CHAIRMAN *[Signature]*

B. Description of corner evidence found and/or method applied in restoring or reestablishing corner:

D-12 Found a capped Roosien iron 0.2' South of the intersection of 1/4 lines. Also found an iron pipe 0.4' South and 0.4' East of the intersection of 1/4 lines. The Roosien iron checks surveys by Roosien, All-Points and Exxel Engineering. Held Roosien iron for the Center of Section.

The selected location is accepted by me and is generally accepted by professional surveyors as the best available evidence of the position of the original corner.

C. Description of monument for corner and accessories established to perpetuate locating the position of the corner:

- D-12 Replaced Roosien Iron with a Standard Kent County Monument
- Nail & K.C. remon. tag on N side 12" Hickory N 70° E 18.13'
 - Nail & K.C. remon. tag on W side 12" Hickory S 15° E 8.95'
 - Nail & K.C. remon. tag on N side 18" W. Cherry S 75° W 32.43'
 - Nail & K.C. remon. tag on NE side 16" Douglas Fir N 50° W 34.43'
 - Iron Pipe 0.4' East and 0.2' South



Signed by *[Signature]* Date 12-20-79
 WILLIAMS & WORKS

Surveyor's Michigan License No. 25854