

SURVEY & REMONUMENTATION

\$7.00
\$2.00

MAR 08 1999

LAND CORNER RECORDATION CERTIFICATE
Filing Requirement of Act 74, Mich. P.A. 1970
KENT COUNTY REMONUMENTATION

For corners in

SECTION

Kent (County)	Located in:	Oakfield Township	Corner Code #
1. Public Land Survey	T <u>9N</u> R <u>9W</u>		<u>D-13</u>
	T _____ R _____		_____
	T _____ R _____		_____
	T _____ R _____		_____
2. Property Controlling in Section	S _____ T _____ R _____		_____
	S _____ T _____ R _____		_____
3. Miscellaneous Property in Sec.	S _____ T _____ R _____		_____
	S _____ T _____ R _____		_____

REG. OF DEEDS

W. J. Kulehouse

38 DEC 14 AM 8:00

STATE OF MICHIGAN
COUNTY OF KENT
RECEIVED FOR RECORD

10955

Register of Deeds Stamp & File Number

4. Lot No. _____, Recorded Plat _____
5. Private Claims _____

I, Randy Kulehouse, in a field survey on January 30 19 98, do hereby certify that under requirements of P.A. 74 Michigan P.A. of 1970, the corner points mentioned in lines 1 and 2 above were in conformance with regulations and rules therefore as required in the current manual of survey instructions of the United States Department of the interior, Bureau of Land Management or by a decree of a Court of Law and/or that the corner points mentioned in lines 3, 4 and 5 above were in conformance with the rules of the Michigan Board of Land Surveyors or by a Decree of a Court of Law; established, re-established, monumented, re-monumented, recovered, found as expressed below:

NOTE: Not more than 4 corners, all in the same town and range, may be recorded on this certificate.

A. Description of original monument and accessories and/or subsequent restoration:

D-13	1837	G.L.O. Notes	N. Brookfield	Set Post
	1963	Witness Map	K.C. Surveyor	1" Iron
	1975	L.C.R.C. #810	Exxel Engineering	1/2" Iron in Mon. Box
	1980	L.C.R.C. #1725	Williams & Works	Fnd. 3/4" Iron in Mon. Box / Set K.C. Monument
	1989	L.C.R.C. #5192	John Bueche	K.C. Monument in Mon. Box
	1997	L.C.R.C. #9655	Kirk Breitels	K.C. Monument in Mon. Box

Note: This corner is not common with D-1, T8N, R9W.

This corner was originally approved by the Kent County Remonumentation Peer Group and monumented by Williams & Works on 12/22/80 and was recorded per L.C.R.C. #1725.

B. Description of corner evidence found and/or method applied in restoring or reestablishing corner:

D-13 Found a Standard Kent County Monument in a monument box 3' ± North of the C/L of 10 Mile Road (bit.) running East and West and 100' ± West of House #10801 per L.C.R.C.'s #1725, #5192 and #9655 as set by Williams & Works in place of a 3/4" iron they found in a monument box over a 3" iron down 19" which checked L.C.R.C. #810 and the K.C. Surveyor's records

L.C.R.C. #1725

L.C.R.C. #9655

K.C. Remon. Tag & Nail in SW Side 8" Oak N 50°W 79.81'
K.C. Remon. Tag & Nail in E Side 8" Twin Maple N 10°W 56.91'
K.C. Remon. Tag & Nail in NW Side 20" Oak N 40°E 67.52'
K.C. Remon. Tag & Nail in E Side 8" Maple in Clump S 35°E 58.88'
K.C. Remon. Tag & Nail in E Side 16" Poplar S 20°W 45.61'
Iron in Mon. Box N 90° W 36.24'

Nail & KC Remon. tag SW side 12" Oak N 50° W 79.69' (m. 79.65')
Nail & KC Remon. tag E side 12" Tw. Maple N 10° W 56.82'
Nail & KC Remon. tag NW side 26" Oak N 40° E 67.49' (m. 67.46')
Nail & KC Remon. tag E side 12" Maple clump S 35° E 58.78 (m. 58.81')
Nail & KC Remon. tag E side 24" Poplar S 20° W 45.60'
K.C. Mon.(D-1, T8N, R9W) West 36.24' (m. 36.22')

The selected location is accepted by me and is generally accepted by professional surveyors as the best available evidence of the position of the original corner.

C. Description of monument for corner and accessories established to perpetuate locating the position of the corner:

D-13 Standard Kent County Monument in a Monument Box

Nail & K.C. remon. tag on SW side 12" Oak N 50° W 79.65'
Nail & K.C. remon. tag on E side 12" twin Maple N 10° W 56.82'
Nail & K.C. remon. tag on NW side 26" Oak N 40° E 67.46'
Nail & K.C. remon. tag on E side 12" Maple clump S 35° E 58.81'
Nail & K.C. remon. tag on E side 24" Poplar S 20° W 45.60'


C/L of bit. road running E-W, South 3' ±
K.C. Mon., D-1, T8N, R9W, West 36.22'

Signed by Randy J. Kulehouse

Date 11/18/98

EARTH TECH

Surveyor's Michigan License No. 25854

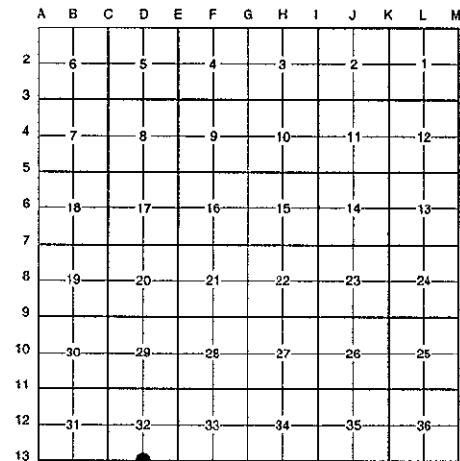

P.A. 345 1990 KENT COUNTY
PEER APPROVED 9/24/98
CHAIRMAN Randy Kulehouse

