

**SURVEY &
REMONUMENTATION**

MAY 22 2000

**LAND CORNER RECORDATION CERTIFICATE
Filing Requirement of Act 74, Mich. P.A. 1970
KENT COUNTY REMONUMENTATION**

For corners in

SECTION

Kent (County)	Located in: Oakfield Township	Corner Code #
1. Public Land Survey	T 9N R 9W	E-2
	T _____ R _____	_____
	T _____ R _____	_____
	T _____ R _____	_____
2. Property Controlling in Section	S _____ T _____ R _____	_____
	S _____ T _____ R _____	_____
3. Miscellaneous Property in Sec.	S _____ T _____ R _____	_____
	S _____ T _____ R _____	_____

REG. OF DEEDS

[Signature]

STATE OF MICHIGAN
COUNTY OF KENT
RECEIVED FOR RECORD
1999 OCT 27 AM 8:37

11420

Register of Deeds Stamp & File Number

4. Lot No. _____, Recorded Plat _____
5. Private Claims _____


I, Randy Kolehouse, in a field survey on March 22 19 99, do hereby certify that under requirements of P.A. 74 Michigan P.A. of 1970, the corner points mentioned in lines 1 and 2 above were in conformance with regulations and rules therefore as required in the current manual of survey instructions of the United States Department of the interior, Bureau of Land Management or by a decree of a Court of Law and/or that the corner points mentioned in lines 3, 4 and 5 above were in conformance with the rules of the Michigan Board of Land Surveyors or by a Decree of a Court of Law; established, re-established, monumented, re-monumented, recovered, found as expressed below:

NOTE: Not more than 4 corners, all in the same town and range, may be recorded on this certificate.

A. Description of original monument and accessories and/or subsequent restoration:

E-2	1837	G.L.O. Notes	Cathcart	Set Post
	1932-67	Witness Map	K.C. Surveyor	Monument
	1978	L.C.R.C. #1113	James Reda	1/2" Iron
	1981	L.C.R.C. #1671	Williams & Works	Fnd. Iron / Set K.C. Monument
	1989	L.C.R.C. #5193	John Bueche	K.C. Monument
	1997	L.C.R.C. #9656	Kirk Breitels	K.C. Monument

P.A. 345 1990 KENT COUNTY
PEER APPROVED 7/29/99
CHAIRMAN [Signature]

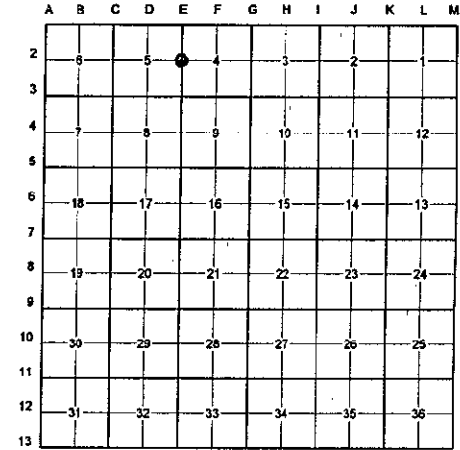

This corner was originally approved by the Kent County Remonumentation Peer Group and monumented by Williams & Works on 4/16/81 and was recorded per L.C.R.C. #1671.

B. Description of corner evidence found and/or method applied in restoring or reestablishing corner:

E-2 Found a Standard Kent County Monument 6' ± West of the C/L of Wabasis Avenue (gravel) running North and South and 6' ± North of the C/L of McClain Street (gravel) running East per L.C.R.C.'s #1666, #5197, and #9661 as set by Williams & Works in place of a 1/2" iron they set which checked L.C.R.C. #659 and the K.C. Surveyor's records.

L.C.R.C. #1671

L.C.R.C. #9656

- K.C. Remon. tag and nail in SW side 30" Maple N.30°W. 19.77'
- K.C. Remon. tag and nail in SE side 18" Pine S.60°W. 43.38'
- K.C. Remon. tag and nail in SE side Power pole N65°E. 68.45'
- K.C. Remon. tag and nail in NE side Power pole N.40°W. 60.00'
- K.C. Remon. tag and nail in SW side 20" Ash N.25°E. 100.75'


- Nail & KC Remon. tag SW side 36" Maple N30°W 19.72' (m. 19.73')
- Nail & KC Remon. tag SE side 26" Pine S60°W 43.27' (m. 43.32')
- Nail & KC Remon. tag SE side Power Pole N65°E 68.50' (m. 68.49')
- Nail & KC Remon. tag NE side Power Pole N40°W 62.04'
- Nail & KC Remon. tag SW side 20" Stump N25°E 100.67'
- Nail & KC Remon. tag SW side 10" Pine S50°E 96.05' (m. 96.07')
- Nail & KC Remon. tag NE side 20" Pine S45°E 109.50' (m. 109.46')
- C/L Wabasis (gravel) N-S is 8'+/- E.

The selected location is accepted by me and is generally accepted by professional surveyors as the best available evidence of the position of the original corner.

C. Description of monument for corner and accessories established to perpetuate locating the position of the corner:

E-2 Standard Kent County Monument

- Nail & K.C. remon. tag on SW side 36" Maple N 30° W 19.73'
- Nail & K.C. remon. tag on SE side 26" Pine S 60° W 43.32'
- Nail & K.C. remon. tag on SE side P. pole N 65° E 68.49'
- Nail & K.C. remon. tag on NE side P. pole N 40° W 62.04'
- Nail & K.C. remon. tag on SW side 20" stump N 25° E 100.67'
- Nail & K.C. remon. tag on SW side 10" Pine S 50° E 96.07'
- Nail & K.C. remon. tag on NE side 20" Pine S 45° E 109.46'
- C/L of gravel road running N-S, East 6' ±
- C/L of gravel road running E, South 6' ±

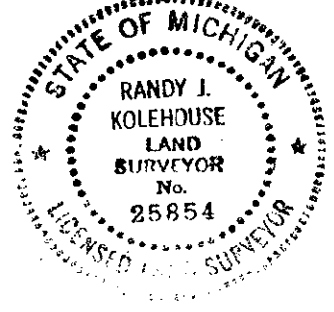

Signed by [Signature]
WILLIAMS & WORKS

Date 10-11-99

Surveyor's Michigan License No. 25854