

MAY 22 2000

LAND CORNER RECORDATION CERTIFICATE

Filing Requirement of Act 74, Mich. P.A. 1970

KENT COUNTY REMONUMENTATION

SECTION

For corners in


Kent (County)	Located in: Oakfield Township	Corner Code #
1. Public Land Survey	T 9N R 9W	E-3
	T R	
	T R	
	T R	
2. Property Controlling in Section	S T R	
	S T R	
3. Miscellaneous Property in Sec.	S T R	
	S T R	

STATE OF MICHIGAN
COUNTY OF KENT
RECEIVED FOR RECORD
1999 OCT 27 AM 8:37
REG. OF DEEDS
11421
Register of Deeds Stamp & File Number

- 4. Lot No. _____, Recorded Plat _____
- 5. Private Claims _____

I, Randy Kolehouse, in a field survey on March 22 19 99, do hereby certify that under requirements of P.A. 74 Michigan P.A. of 1970, the corner points mentioned in lines 1 and 2 above were in conformance with regulations and rules therefore as required in the current manual of survey instructions of the United States Department of the interior, Bureau of Land Management or by a decree of a Court of Law and/or that the corner points mentioned in lines 3, 4 and 5 above were in conformance with the rules of the Michigan Board of Land Surveyors or by a Decree of a Court of Law; established, re-established, monumented, re-monumented, recovered, found as expressed below.

NOTE: Not more than 4 corners, all in the same town and range, may be recorded on this certificate.

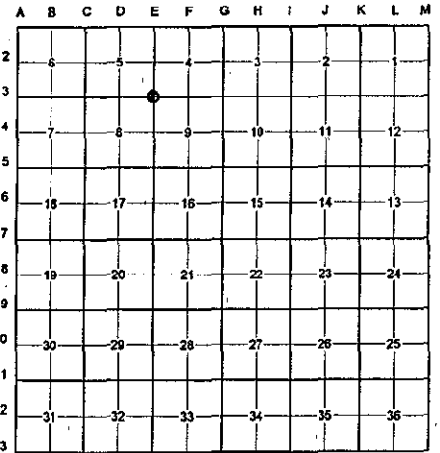

A. Description of original monument and accessories and/or subsequent restoration:

E-3	1837	G.L.O. Notes	Cathcart	Set Post
	1938-63	Witness Map	K.C. Surveyor	Monument
	1981	L.C.R.C. #2087	Nederveld & Jonker	Conc. Monument
	1982	L.C.R.C. #2872	Jonker Land Surveys	Fnd. Conc. Monument / Set K.C. Monument
	1989	L.C.R.C. #5194	John Bueche	K.C. Monument
	1997	L.C.R.C. #9657	Kirk Breitels	K.C. Monument

This corner was originally approved by the Kent County Remonumentation Peer Group and monumented by Rob Jonker on 5/19/82 and was recorded per L.C.R.C. #2872.

B. Description of corner evidence found and/or method applied in restoring or reestablishing corner:

E-3 Found a Standard Kent County Monument at the C/L intersection of Wabasis Avenue (gravel) running North and South and 15 Mile Road (gravel) running West per L.C.R.C.'s #2872, #5194, and #9657 as set by Rob Jonker in place of a 4" x 9" broken concrete monument which checked L.C.R.C. #2087 and the K.C. Surveyor's records.

L.C.R.C. #2872

Remon. tag on NW side 30" Maple N50°E 39.22'
Remon. tag on N side 16" Maple N85°E 40.88'
Remon. tag on NE side 16" Maple S30°E 54.56'

L.C.R.C. #9657

Nail & KC Remon. tag NW side 34" Maple N50°E 39.19' (m. 39.11')
Nail & KC Remon. tag N. side 20" Maple N85°E 40.84' (m. 40.85')
Nail & KC Remon. tag NE side 20" Maple S30°E 54.56'
Nail & KC Remon. tag SW side P. Pole N40°W 119.10' (m. 119.09')
Nail & KC Remon. tag SW side 16" Oak S75°E 32.22' (m. 32.28')
Nail & KC Remon. tag N. side 10" Birch S70°W 102.00' (m. 101.82')

The selected location is accepted by me and is generally accepted by professional surveyors as the best available evidence of the position of the original corner.

C. Description of monument for corner and accessories established to perpetuate locating the position of the corner:


E-3 Standard Kent County Monument

Nail & K.C. remon. tag on NW side 34" Maple N 50° E 39.11'
Nail & K.C. remon. tag on N side 20" Maple N 85° E 40.85'
Nail & K.C. remon. tag on NE side 20" Maple S 30° E 54.56'
Nail & K.C. remon. tag on SW side P. pole N 40° W 119.09'
Nail & K.C. remon. tag on SW side 16" Oak S 75° E 32.28'
Nail & K.C. remon. tag on N side 10" Birch S 70° W 101.82'
On C/L "X" of gravel roads running N-S & W

P.A. 345 1990 KENT COUNTY

PEER APPROVED 7/29/99

CHAIRMAN *[Signature]*

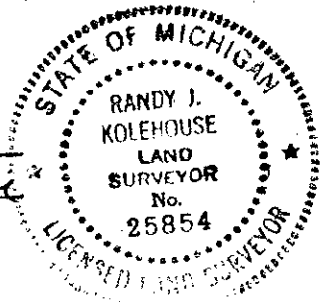

Signed by *[Signature]*

Date 10-11-99

WILLIAMS & WORKS

Surveyor's Michigan License No. 25854