

SURVEY & REMONUMENTATION

\$7.00
\$2.00

MAY 22 2000

SECTION LAND CORNER RECORDATION CERTIFICATE
Filing Requirement of Act 74, Mich. P.A. 1970
KENT COUNTY REMONUMENTATION

STATE OF MICHIGAN
COUNTY OF KENT
RECEIVED FOR RECORD
1999 DEC - 8 AM 10: 06

REG. OF DEEDS

11546

Register of Deeds Stamp & File Number


For corners in

Kent (County)	Located in: Oakfield Township	Corner Code #
1. Public Land Survey	T 9N R 9W	E-4
	T R	
	T R	
	T R	
2. Property Controlling in Section	S T R	
	S T R	
3. Miscellaneous Property in Sec.	S T R	
	S T R	

4. Lot No. _____, Recorded Plat _____
5. Private Claims _____

I, Randy Kolehouse, in a field survey on August 31 19 99, do hereby certify that under requirements of P.A. 74 Michigan P.A. of 1970, the corner points mentioned in lines 1 and 2 above were in conformance with regulations and rules therefore as required in the current manual of survey instructions of the United States Department of the interior, Bureau of Land Management or by a decree of a Court of Law and/or that the corner points mentioned in lines 3, 4 and 5 above were in conformance with the rules of the Michigan Board of Land Surveyors or by a Decree of a Court of Law; established, re-established, monumented, re-monumented, recovered, found as expressed below:

NOTE: Not more than 4 corners, all in the same town and range, may be recorded on this certificate.

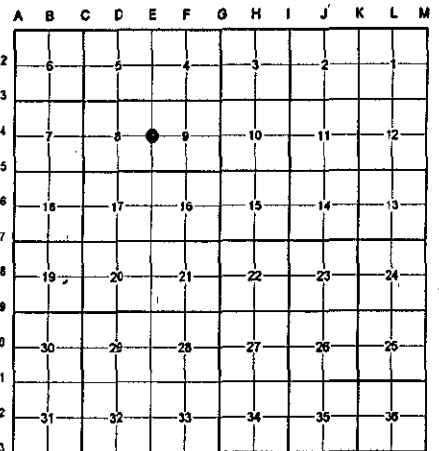

A. Description of original monument and accessories and/or subsequent restoration:

E-4	1837	G.L.O. Notes	Cathcart	Set Post
	1938-63	Witness Map	K.C. Surveyor	Iron
	1984	L.C.R.C. #3715	All-Points Surveyors	1" Iron
	1992	L.C.R.C. #6583	John Bueche	Fnd. Iron / Set K.C. Monument
	1997	L.C.R.C. #9658	Kirk Breiteils	K.C. Monument

P.A. 345 1990 KENT COUNTY
PEER APPROVED 10/23/99
CHAIRMAN Randy Kolehouse

This corner was originally approved by the Kent County Remonumentation Peer Group and monumented by John Bueche in August 1992 and was recorded per L.C.R.C. #6583.

B. Description of corner evidence found and/or method applied in restoring or reestablishing corner:

E-4 Found a Standard Kent County Monument on the C/L of Wabasis Avenue (gravel) running North and South, 7' ± South of the South edge of Sandy Bottom Street (gravel) running East and West, and 25' ± North of the North edge of Sandy Bottom Lake per L.C.R.C.'s #6583 and #9658 as set by John Bueche in place of a 1"x18" iron he found which checked L.C.R.C. #3715 and the K.C. Surveyor's records.

L.C.R.C. #6583

L.C.R.C. #9658

Nail & K.C. Remon. Tag in S side 12" Oak N 25° E 101.09'
Nail & K.C. Remon. Tag in W side 14" Oak N 20° W 78.42'
Nail & K.C. Remon. Tag in W side 14" Oak N 70° W 74.81'
Nail & K.C. Remon. Tag in N side 12" Oak S 70° W 17.62'
7'+/- S of edge of road, 25'+/- N of N edge of Lake
On C/L gravel N

Cut Nail in N. side 20" Oak N75°E 19.34' (m. 19.39')
Nail & KC Remon. tag E. side 14" Oak N25°E 101.09' (m. 101.24')
Nail & KC Remon. tag W. side 16" Oak N20°W 78.38' (m. 78.49')
Nail & KC Remon. tag S. side 16" Oak N70°W 74.77' (m. 74.84')
Nail & KC Remon. tag N. side 14" Oak S70°W 17.62' (m. 17.71')
7'+/- S. of edge of road, 25'+/- N. of edge of Lake
On C/L gravel N.

The selected location is accepted by me and is generally accepted by professional surveyors as the best available evidence of the position of the original corner.

C. Description of monument for corner and accessories established to perpetuate locating the position of the corner:

E-4 Standard Kent County Monument

Nail & K.C. remon. tag on N side 20" Oak N 75° E 19.39'
Nail & K.C. remon. tag on E side 14" Oak N 25° E 101.24'
Nail & K.C. remon. tag on W side 16" Oak N 20° W 78.49'
Nail & K.C. remon. tag on S side 16" Oak N 70° W 74.84'
Nail & K.C. remon. tag on N side 14" Oak S 70° W 17.71'
7'+/- S. of edge of road, 25'+/- N. of edge of lake
On C/L of gravel road running N-S
South edge of gravel road running E-W, North 7' ±

Signed by Randy J. Kolehouse Date _____

WILLIAMS & WORKS

Surveyor's Michigan License No. 25854

