

MAY 22 2000

SECTION

LAND CORNER RECORDATION CERTIFICATE  
Filing Requirement of Act 74, Mich. P.A. 1970  
KENT COUNTY REMONUMENTATION

For corners in

Kent (County)	Located in: Township	Oakfield	Corner Code #
1. Public Land Survey	T <u>9N</u>	R <u>9W</u>	<u>E-5</u>
	T _____	R _____	_____
	T _____	R _____	_____
	T _____	R _____	_____
2. Property Controlling In Section	S _____	T _____	R _____
	S _____	T _____	R _____
3. Miscellaneous Property in Sec.	S _____	T _____	R _____
	S _____	T _____	R _____

REG. OF DEEDS


*[Signature]*

STATE OF MICHIGAN  
COUNTY OF KENT  
RECEIVED FOR RECORD  
1999 OCT 27 AM 8:37

11422

Register of Deeds Stamp & File Number

4. Lot No. \_\_\_\_\_, Recorded Plat \_\_\_\_\_  
5. Private Claims \_\_\_\_\_

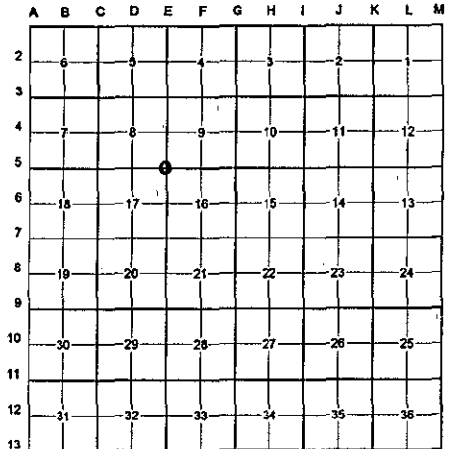

I, Randy Kolehouse, in a field survey on March 22 19 99, do hereby certify that under requirements of P.A. 74 Michigan P.A. of 1970, the corner points mentioned in lines 1 and 2 above were in conformance with regulations and rules therefore as required in the current manual of survey instructions of the United States Department of the Interior, Bureau of Land Management or by a decree of a Court of Law and/or that the corner points mentioned in lines 3, 4 and 5 above were in conformance with the rules of the Michigan Board of Land Surveyors or by a Decree of a Court of Law; established, re-established, monumented, re-monumented, recovered, found as expressed below:

NOTE: Not more than 4 corners, all in the same town and range, may be recorded on this certificate.

A. Description of original monument and accessories and/or subsequent restoration:

E-5	1837	G.L.O. Notes	Cathcart	Set Post
	1963	Witness Map	K.C. Surveyor	Iron
	1974	L.C.R.C. #659	F.E. Spicer	1/2" Iron in Mon. Box
	1981	L.C.R.C. #1661	Williams & Works	Fnd. Iron / Set K.C. Monument
	1989	L.C.R.C. #5195	John C. Bueche	K.C. Monument
	1997	L.C.R.C. #9659	Kirk Breitels	K.C. Monument

P.A. 345 1990 KENT COUNTY  
PEER APPROVED 7/29/99  
CHAIRMAN [Signature]

This corner was originally approved by the Kent County Remonumentation Peer Group and monumented by Williams & Works on 4/17/81 and was recorded per L.C.R.C. #1661.

B. Description of corner evidence found and/or method applied in restoring or reestablishing corner:

E-5 Found a Standard Kent County Monument 18' ± South of the C/L intersection of 14 Mile Road (bit.) running East and West and Wabasis Avenue (gravel) running North and South per L.C.R.C.'s #1661, #5195, and #9659, as set by Williams & Works in place of a 1/2" x 18" iron they found over a 1/2" x 18" iron in a monument box which checked L.C.R.C. #659 and the K.C. Surveyor's records.

L.C.R.C. #1661

L.C.R.C. #9659

NE Cor. Church (Fdn.) S 50°W 128.35'  
SE Cor. C.B. Hood S 85°W 98.18'  
NW Cor. C.B. Hood S 15°W 81.85'  
NW Cor. Conc. Hdwall. S 45°E 93.44'  
K.C. Remon. Tag & Nail in E. Side Tel. Pole N 30°E 101.33'  
K.C. Remon. Tag & Nail in Conc. Curb Joint N 10°W 64.12'  
C/L 14 Mile Rd. (Blktp.) E & W 18' North  
On C/L Wabasis (gravel) North, (Blktp.) South  
Nails S 2.05 & W 2.00

NE corner church foundation S50°W 128.35' (m. 128.30')  
SE corner catch basin hood S85°W 98.18' (m. 98.13')  
NW corner catch basin hood S15°W 81.88' (m. 81.86')  
NW corner conc. Headwall S45°E 93.55' (m. 93.60')  
Nail & KC Remon. tag E. side T. Pole N30°E 101.39' (m. 101.38')  
Nail & KC Remon. tag in conc. Curb joint N10°W 64.09' (m. 64.06')  
C/L 14 Mile Rd. E-W is 18' North +/-  
On C/L Wabasis N-S +/-

The selected location is accepted by me and is generally accepted by professional surveyors as the best available evidence of the position of the original corner.

C. Description of monument for corner and accessories established to perpetuate locating the position of the corner:

E-5 Standard Kent County Monument

NE cor. church (conc. Fdn.) S 50° W 128.30'  
SE cor. C.B. hood S 85° W 98.13'  
NW cor. C.B. hood S 15° W 81.86'  
NW cor. conc. headwall to culvert S 45° E 93.60'  
Nail & K.C. remon. tag on E side P. pole N 30° E 101.38'

Nail & K.C. remon. tag on conc. curb joint N 10° W 64.06'  
On C/L of gravel road running N-S  
C/L of bit. road running E-W, North 18' ±

Signed by *[Signature]* Date 10-11-99  
WILLIAMS & WORKS  
Surveyor's Michigan License No. 25854

