

**SURVEY &
REMONUMENTATION**

\$7.00
\$2.00

MAY 22 2000

SECTION

**LAND CORNER RECORDATION CERTIFICATE
Filing Requirement of Act 74, Mich. P.A. 1970
KENT COUNTY REMONUMENTATION**

For corners in

| | | |
|---------------------------------------|---|-----------------------------|
| <u>Kent</u> (County) | Located in: <u>Oakfield</u> Township | Corner Code # <u>E-6</u> |
| 1. Public Land Survey | T <u>9N</u> R <u>9W</u> | <u>E-6</u> |
| | T _____ R _____ | _____ |
| | T _____ R _____ | _____ |
| | T _____ R _____ | _____ |
| 2. Property Controlling in Section | S _____ T _____ R _____ | _____ |
| | S _____ T _____ R _____ | _____ |
| 3. Miscellaneous Property in Sec. | S _____ T _____ R _____ | _____ |
| | S _____ T _____ R _____ | _____ |

REG. OF DEEDS

STATE OF MICHIGAN
COUNTY OF KENT
RECEIVED FOR RECORD
1999 OCT 27 AM 8:37

11423

Register of Deeds Stamp & File Number

4. Lot No. _____, Recorded Plat _____
5. Private Claims _____

I, Randy Kolehouse, in a field survey on March 17 19 99, do hereby certify that under requirements of P.A. 74 Michigan P.A. of 1970, the corner points mentioned in lines 1 and 2 above were in conformance with regulations and rules therefore as required in the current manual of survey instructions of the United States Department of the interior, Bureau of Land Management or by a decree of a Court of Law and/or that the corner points mentioned in lines 3, 4 and 5 above were in conformance with the rules of the Michigan Board of Land Surveyors or by a Decree of a Court of Law; established, re-established, monumented, re-monumented, recovered, found as expressed below:

NOTE: Not more than 4 corners, all in the same town and range, may be recorded on this certificate.

A. Description of original monument and accessories and/or subsequent restoration:

| | | | | |
|-----|------|----------------|---------------------|-------------------------------|
| E-6 | 1837 | G.L.O. Notes | Cathcart | Set Post |
| | 1963 | Witness Map | K.C. Surveyor | 1" Iron |
| | 1979 | L.C.R.C. #1261 | Exxel Engineering | 1" Iron |
| | 1981 | L.C.R.C. #1860 | Jonker Land Surveys | Fnd. Iron / Set K.C. Monument |
| | 1989 | L.C.R.C. #5196 | John Bueche | K.C. Monument |
| | 1997 | L.C.R.C. #9660 | Kirk Breitels | K.C. Monument |

P.A. 345 1990 KENT COUNTY
PEER APPROVED 7/29/99
CHAIRMAN [Signature]



This corner was originally approved by the Kent County Remonumentation Peer Group and monumented by Rob Jonker on 5/29/81 and was recorded per L.C.R.C. #1860.

B. Description of corner evidence found and/or method applied in restoring or reestablishing corner:

E-6 Found a Standard Kent County Monument on the C/L of Wabasis Avenue (bit.) running North and South per L.C.R.C.'s #1860, 35196, and #9660 as set by Rob Jonker in place of a 1" iron he found which checked L.C.R.C. #1261 and the K.C. Surveyor's records.

L.C.R.C. #1860

- Remon. tag on E side 36" oak N20°W 123.11
- Remon. tag on N side 14" oak N85°E 41.24
- Remon. tag on N side 8" Hickory S85°E 48.94
- Remon. tag on E side P. pole S15°W 268.13
- On centerline N-S. B. T.

L.C.R.C. #9660


- Nail & KC Remon. tag E. side 42" Oak N20°W 123.02' (m. 122.98')
- Nail & KC Remon. tag N. side 22" Oak N70°E 41.21' (m. 41.17')
- Nail & KC Remon. tag N. side 14" Hickory S85°E 48.90' (m. 48.88')
- Nail & KC Remon. tag E. side P. Pole S15°W 268.13' (m. 268.12')
- 1" Iron Pipe East 32.58' (m. 32.57')
- Nail & KC Remon. tag W. side 12" Hickory N35°E 47.78' (47.79')
- On C/L N-S blacktop

The selected location is accepted by me and is generally accepted by professional surveyors as the best available evidence of the position of the original corner.

C. Description of monument for corner and accessories established to perpetuate locating the position of the corner:

E-6 Standard Kent County Monument

- Nail & K.C. remon. tag on E side 42" Oak N 20° W 122.98'
- Nail & K.C. remon. tag on N side 22" Oak N 70° E 41.17'
- Nail & K.C. remon. tag on N side 14" Hickory S 85° E 48.88'
- Nail & K.C. remon. tag on E side P. pole S 15° W 268.12'
- Nail & K.C. remon. tag on W side 12" Hickory N 35° E 47.79'
- 1" iron pipe East 32.57'
- On C/L of bit. road running N-S

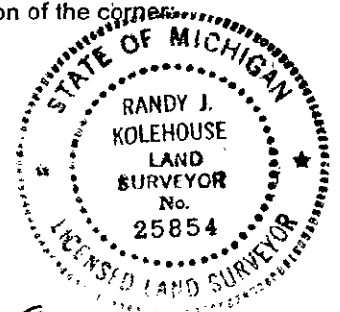

Signed by [Signature]

Date 10-11-99

WILLIAMS & WORKS

Surveyor's Michigan License No. 25854