

MAY 22 2000

LAND CORNER RECORDATION CERTIFICATE
Filing Requirement of Act 74, Mich. P.A. 1970
KENT COUNTY REMONUMENTATION

SECTION

For corners in

Table with columns: Kent (County), Located in: Oakfield Township, Corner Code #. Rows include Public Land Survey, Property Controlling in Section, Miscellaneous Property in Sec., and Recorded Plat.

REG. OF DEEDS

Handwritten signature/initials

STATE OF MICHIGAN
COUNTY OF KENT
RECEIVED FOR RECORD
1999 OCT 27 AM 8:37

11424

Register of Deeds Stamp & File Number


- 4. Lot No. Recorded Plat
5. Private Claims

I, Randy Kolehouse, in a field survey on March 16 19 99, do hereby certify that under requirements of P.A. 74 Michigan P.A. of 1970, the corner points mentioned in lines 1 and 2 above were in conformance with regulations and rules therefore as required in the current manual of survey instructions of the United States Department of the interior, Bureau of Land Management or by a decree of a Court of Law and/or that the corner points mentioned in lines 3, 4 and 5 above were in conformance with the rules of the Michigan Board of Land Surveyors or by a Decree of a Court of Law; established, re-established, monumented, re-monumented, recovered, found as expressed below:

NOTE: Not more than 4 corners, all in the same town and range, may be recorded on this certificate.

A. Description of original monument and accessories and/or subsequent restoration:

Table with 4 columns: E-7 1837, G.L.O. Notes, Cathcart, Set Post. Rows list various monuments like Witness Map, L.C.R.C. #659, #1666, #5197, #9661 and their descriptions.

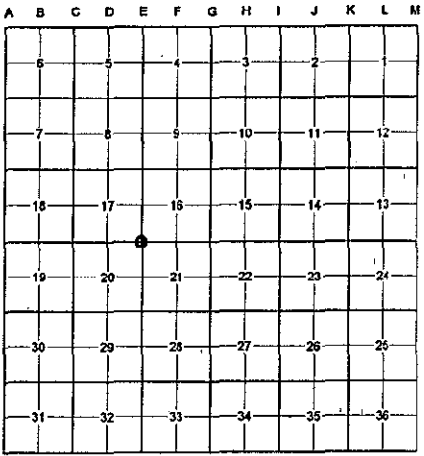

P.A. 345 1990 KENT COUNTY
PEER APPROVED 7/29/99
CHAIRMAN [Signature]

This corner was originally approved by the Kent County Remonumentation Peer Group and monumented by Williams & Works on 4/17/81 and was recorded per L.C.R.C. #1666.

B. Description of corner evidence found and/or method applied in restoring or reestablishing corner:

E-7 Found a Standard Kent County Monument at the C/L intersection of Wabasis Street (bit.) running North and South and 13 Mile Road (gravel) running East and West per L.C.R.C.'s #1666, #5197, and #9661 as set by Williams & Works in place of a 3/4" x 18" iron they found over a 1-1/4" x 18" iron which checked L.C.R.C. #659 and the K.C. Surveyor's records.

L.C.R.C. #1666

L.C.R.C. #9661

K.C. Remon. Tag & Nail in S. Side 48" Oak N 5°W 145.24'
K.C. Remon. Tag & Nail in S. Side 36" Maple N 75°W 144.26'
K.C. Remon. Tag & Nail in W. Side Power Pole S 40°W 112.53'
SE Cor. Hse. #11181 (Fnd.) N 45°W 134.79'
SW Cor. Conc. Base to MBT Box N 80°E 112.95'


Nail & KC Remon. tag E. side 54" Oak N05°W 155.66' (m. 155.66')
Nail & KC Remon. tag S. side 44" Maple N75°W 143.87' (m. 143.90')
Nail & KC Remon. tag W. side P. Pole S40°W 114.61' (m. 114.60')
SE cor. Hse. #11181 fnd. N45°W 134.73' (m. 134.76')
SW cor. conc. base to MBT box N80°E 112.95' (m. 112.97')
NW corner house foundation S30°E 172.33' (m. 172.40')

The selected location is accepted by me and is generally accepted by professional surveyors as the best available evidence of the position of the original corner.

C. Description of monument for corner and accessories established to perpetuate locating the position of the corner:

E-7 Standard Kent County Monument

Nail & K.C. remon. tag on E side 54" Oak N 05° W 155.66'
Nail & K.C. remon. tag on S side 44" Maple N 75° W 143.90'
Nail & K.C. remon. tag on W side P. pole S 40° W 114.60'
SE cor. Hse. #11181 fndn. N 45° W 134.76'
SW cor. conc. base to MBT box N 80° E 112.97'
NW cor. hse. fndn. S 30° E 172.40'
C/L "X" of bit. road running N-S & gravel road running E-W

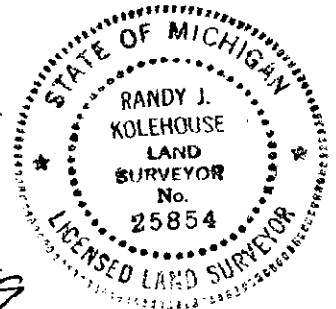

Signed by [Signature] WILLIAMS & WORKS

Date 10-11-99

Surveyor's Michigan License No. 25854