

MAY 22 2000

\$7.00
\$2.00

SECTION LAND CORNER RECORDATION CERTIFICATE
Filing Requirement of Act 74, Mich. P.A. 1970
KENT COUNTY REMONUMENTATION

For corners in

Kent (County)	Located in: Oakfield Township	Corner Code #
1. Public Land Survey	T <u>9N</u> R <u>9W</u>	<u>E-8</u>
	T _____ R _____	_____
	T _____ R _____	_____
	T _____ R _____	_____
2. Property Controlling in Section	S _____ T _____ R _____	_____
	S _____ T _____ R _____	_____
3. Miscellaneous Property in Sec.	S _____ T _____ R _____	_____
	S _____ T _____ R _____	_____

REG. OF DEEDS


[Signature]

STATE OF MICHIGAN
COUNTY OF KENT
RECEIVED FOR RECORD
1999 OCT 27 AM 8:37

11425

Register of Deeds Stamp & File Number

4. Lot No. _____, Recorded Plat _____
5. Private Claims _____

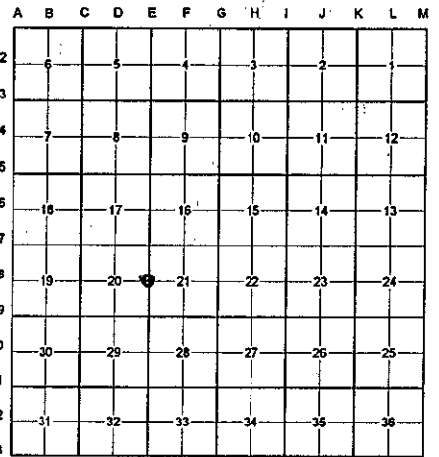

I, Randy Kolehouse, in a field survey on March 10 19 99, do hereby certify that under requirements of P.A. 74 Michigan P.A. of 1970, the corner points mentioned in lines 1 and 2 above were in conformance with regulations and rules therefore as required in the current manual of survey instructions of the United States Department of the interior, Bureau of Land Management or by a decree of a Court of Law and/or that the corner points mentioned in lines 3, 4 and 5 above were in conformance with the rules of the Michigan Board of Land Surveyors or by a Decree of a Court of Law; established, re-established, monumented, re-monumented, recovered, found as expressed below:

NOTE: Not more than 4 corners, all in the same town and range, may be recorded on this certificate.

A. Description of original monument and accessories and/or subsequent restoration:

E-8	1837	G.L.O. Notes	Cathcart	Set Post
	1940	Witness Map	K.C. Surveyor	Monument
	1981	L.C.R.C. #1467	Williams & Works	Fnd. Iron In Mon. Box / Set K.C. Mon. in Mon. Box
	1989	L.C.R.C. #5198	John Bueche	K.C. Mon. in Mon. Box
	1997	L.C.R.C. #9662	Kirk Breitels	K.C. Monument

P.A. 345 1990 KENT COUNTY
PEER APPROVED 7/29/99
CHAIRMAN *[Signature]*

This corner was originally approved by the Kent County Remonumentation Peer Group and monumented by Williams & Works on 10/30/80 and was recorded per L.C.R.C. #1467.

B. Description of corner evidence found and/or method applied in restoring or reestablishing corner:

E-8 Found a Standard Kent County Monument 2' West of the C/L intersection of Wabasis Avenue (bit.) running North and South and Elkins Street (bit.) running East per L.C.R.C.'s #1467, #5198, and #9662 as set by Williams & Works in place of a 3/4" iron they found in a monument box which checked the K.C. Surveyor's records.

L.C.R.C. #1467

L.C.R.C. #9662

- K.C. Remon. Tag & Nail Curb in Joint N 45°E 36.26'
- K.C. Remon. Tag & Nail N Side 32" Pine S 62°E 70.40'
- K.C. Remon. Tag & Nail S Side 18" Hickory S 78°E 139.51'
- "X" Cut in Top SE End Conc. Culv. S 18°E 64.00'
- "X" Cut in Top SW End Culv. S 18°W 63.73'
- K.C. Remon. Tag & Nail E Side C.P. Pole N 20°W 148.15'

- PK Nail & KC Remon. tag in curb joint N45°E 36.33'
- Nail & KC Remon. tag N. side 36" Pine S62°E 70.32' (m. 70.30')
- Nail & KC Remon. tag S. side 24" Hickory S78°E 139.53' (m. 139.60')
- "X" cut in top SE end conc. culv. S18°E 64.05'
- "X" cut in top SW end conc. culv. S18°W 63.73' (m. 63.71')
- Nail & KC Remon. tag E. side CP Pole N20°W 158.30' (m. 158.33')

The selected location is accepted by me and is generally accepted by professional surveyors as the best available evidence of the position of the original corner.

C. Description of monument for corner and accessories established to perpetuate locating the position of the corner:

E-8 Standard Kent County Monument

- Nail & K.C. remon. tag on curb joint N 45° E 36.33'
- Nail & K.C. remon. tag on N side 36" Pine S 62° E 70.30'
- Nail & K.C. remon. tag on S side 24" Hickory S 78° E 139.60'
- "X" cut in top SE end conc. culv. S 18° E 64.05'
- "X" cut in top SW end conc. culv. S 18° W 63.71'
- Nail & K.C. remon. tag on E side C.P. pole N 20° W 158.33'
- C/L "X" of bit. roads running N-S & E, East 2'



Signed by *[Signature]* Date 10-11-99
WILLIAMS & WORKS

Surveyor's Michigan License No. 25854