

MAY 22 2000

SECTION

LAND CORNER RECORDATION CERTIFICATE
Filing Requirement of Act 74, Mich. P.A. 1970
KENT COUNTY REMONUMENTATION

For corners in

Table with columns: Kent (County), Located in: Oakfield Township, Corner Code #. Rows include Public Land Survey, Property Controlling in Section, and Miscellaneous Property in Sec.

REG. OF DEEDS

STATE OF MICHIGAN
COUNTY OF KENT
RECEIVED FOR RECORD
1999 OCT 27 AM 8:37

11426

Register of Deeds Stamp & File Number

- 4. Lot No.
5. Private Claims


I, Randy Kolehouse, in a field survey on March 10 19 99, do hereby certify that under requirements of P.A. 74 Michigan P.A. of 1970, the corner points mentioned in lines 1 and 2 above were in conformance with regulations and rules therefore as required in the current manual of survey instructions of the United States Department of the Interior, Bureau of Land Management or by a decree of a Court of Law and/or that the corner points mentioned in lines 3, 4 and 5 above were in conformance with the rules of the Michigan Board of Land Surveyors or by a Decree of a Court of Law; established, re-established, monumented, re-monumented, recovered, found as expressed below:

NOTE: Not more than 4 corners, all in the same town and range, may be recorded on this certificate.

A. Description of original monument and accessories and/or subsequent restoration:

Table with columns: E-9, 1837, 1935, 1983, 1992, 1997, G.L.O. Notes, Witness Map, L.C.R.C. #3334, L.C.R.C. #6584, L.C.R.C. #9663, Cathcart, K.C. Surveyor, Glaza & Associates, John Bueche, Kirk Breitels, Set Post, Iron, 1" Iron, Fnd. Iron - Set K.C. Monument, K.C. Monument

P.A. 345 1990 KENT COUNTY
PEER APPROVED 7/29/99
CHAIRMAN [Signature]

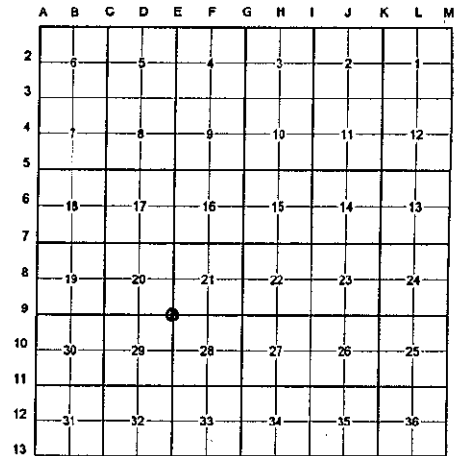

This corner was originally approved by the Kent County Remonumentation Peer Group and monumented by John Bueche in August 1992 and was recorded per L.C.R.C. #6584.

B. Description of corner evidence found and/or method applied in restoring or reestablishing corner:

E-9 Found a Standard Kent County Monument 3.5' West of the C/L intersection of Wabasis Avenue (bit.) running North and South and 12 Mile Road (bit.) running West, on a tree row running East, per L.C.R.C.'s #6584 and #9663 as set by John Bueche in place of a 1" x 18" iron he found over a 2" iron in a monument box which checked L.C.R.C. #3334 and the K.C. Surveyor's records.

L.C.R.C. #6584

L.C.R.C. #9663

- Nail & K.C. Remon. Tag W side of PP N 22° E 90.07'
Nail & K.C. Remon. Tag SW side of 8" Poplar N 45° W 86.86'
Nail & K.C. Remon. Tag SW side of 8" Poplar N 65° W 85.24'
Nail & K.C. Remon. Tag N side of dbl. 12" W. Cherry S 65° W 109.64'
Nail & K.C. Remon. Tag N side of 6" Sassafras S 22° W 96.64'


- Nail & KC Remon. tag W. side P. Pole N22°E 90.03'
Nail & KC Remon. tag SW side 10" Poplar N45°W 86.81' (m. 86.80')
Nail & KC Remon. tag SW side 8" Poplar N65°W 85.20' (m. 85.17')
Nail & KC Remon. tag N. side dbl. 14" Cherry S65°W 108.96' (m. 108.97')
Nail & KC Remon. tag NW side P. Pole S40°W 107.23' (m. 107.20')

The selected location is accepted by me and is generally accepted by professional surveyors as the best available evidence of the position of the original corner.

C. Description of monument for corner and accessories established to perpetuate locating the position of the corner:

E-9 Standard Kent County Monument

- Nail & K.C. remon. tag on W side P. pole N 22° E 90.03'
Nail & K.C. remon. tag on SW side 10" Poplar N 45° W 86.80'
Nail & K.C. remon. tag on SW side 8" Poplar N 65° W 85.17'
Nail & K.C. remon. tag on N side dbl. 14" Cherry S 65° W 108.97'
Nail & K.C. remon. tag on NW side P. pole S 40° W 107.20'
C/L "X" of bit. roads running N-S & W, East 3.5'
On tree row running E

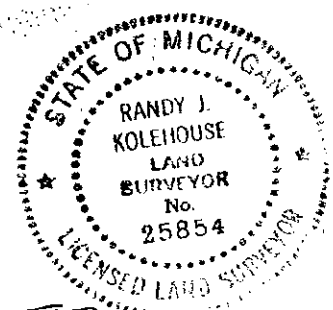

Signed by [Signature] WILLIAMS & WORKS

Date 10-11-99

Surveyor's Michigan License No. 25854