

MAY 22 2000

SECTION LAND CORNER RECORDATION CERTIFICATE
Filing Requirement of Act 74, Mich. P.A. 1970
KENT COUNTY REMONUMENTATION

For corners in

Table with columns: Kent (County), Located in: Oakfield Township, Corner Code #. Rows include Public Land Survey, Property Controlling in Section, and Miscellaneous Property in Sec.

REG. OF DEEDS

STATE OF MICHIGAN
COUNTY OF KENT
RECEIVED FOR RECORD
1999 OCT 27 AM 8:37

11427

Register of Deeds Stamp & File Number

- 4. Lot No. Recorded Plat
5. Private Claims


I, Randy Kolehouse, in a field survey on March 17 19 99, do hereby certify that under requirements of P.A. 74 Michigan P.A. of 1970, the corner points mentioned in lines 1 and 2 above were in conformance with regulations and rules therefore as required in the current manual of survey instructions of the United States Department of the Interior, Bureau of Land Management or by a decree of a Court of Law and/or that the corner points mentioned in lines 3, 4 and 5 above were in conformance with the rules of the Michigan Board of Land Surveyors or by a Decree of a Court of Law; established, re-established, monumented, re-monumented, recovered, found as expressed below:

NOTE: Not more than 4 corners, all in the same town and range, may be recorded on this certificate.

A. Description of original monument and accessories and/or subsequent restoration:

Table with columns: E-11, Year, Description, Material. Includes entries for 1837, 1950, 1975, 1981, 1989, 1997.

P.A. 345 1990 KENT COUNTY, PEER APPROVED 7/29/99, CHAIRMAN Randy Kolehouse

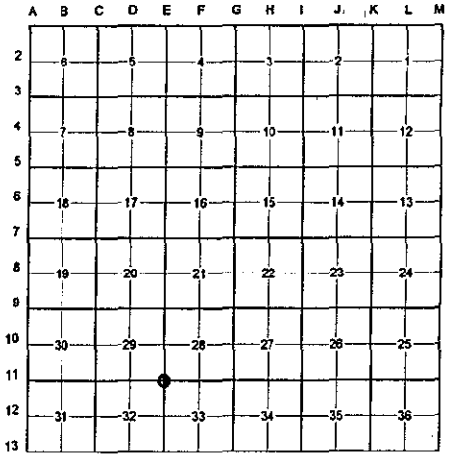

This corner was originally approved by the Kent County Remonumentation Peer Group and monumented by Williams & Works on 4/13/99 and was recorded per L.C.R.C. #1678.

B. Description of corner evidence found and/or method applied in restoring or reestablishing corner:

E-11 Found a Standard Kent County Monument on line of a fence line running East and West per L.C.R.C.'s #1678, #5199, and #9667 as set by Williams & Works in place of a 3/4" x 18" iron they found which checked L.C.R.C. #810 and the K.C. Surveyor's records.

L.C.R.C. #1678

L.C.R.C. #9667

K.C. Remon. tag and nail in N side Tri 12" Hickory S.80°W. 14.45' SE cor metal light post N.10°W. 136.63'/corner is south of Camp Site #30, also large stone 46"+/- east


Nail & KC Remon. tag N. side Tri. 8"-16" Hickory S80°W 14.32' (m. 14.31')
Nail & KC Remon. tag S. side 12" Oak S85°E 19.14' (m. 19.13')
Nail & KC Remon. tag W. side 12" Cherry N10°E 2.84'
Nail & KC Remon. tag E. side 8" Oak S25°E 17.48' (m. 17.46')
SE corner metal light post N10°W 136.73' (m. 136.72')
Corner is in woods South of campsite #30

The selected location is accepted by me and is generally accepted by professional surveyors as the best available evidence of the position of the original corner.

C. Description of monument for corner and accessories established to perpetuate locating the position of the corner:

E-11 Standard Kent County Monument

Nail & K.C. remon. tag on N side triple 8"-16" Hickory S 80° W 14.31'
Nail & K.C. remon. tag on S side 12" Oak S 85° E 19.13'
Nail & K.C. remon. tag on W side 12" Cherry N 10° E 2.84'
Nail & K.C. remon. tag on E side 8" Oak S 25° E 17.46'
SE cor. metal light post N 10° W 136.72'
Corner is on woods line South of Campsite #31
On fence line running E-W

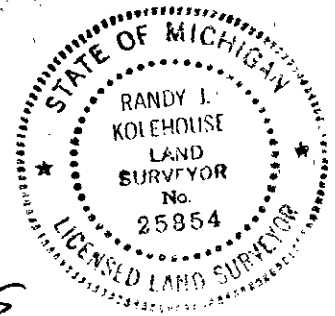

Signed by Randy J. Kolehouse, WILLIAMS & WORKS

Date 10-11-99

Surveyor's Michigan License No. 25854