

MAY 22 2000

**SECTION LAND CORNER RECORDATION CERTIFICATE**

Filing Requirement of Act 74, Mich. P.A. 1970

KENT COUNTY REMONUMENTATION

For corners in

Kent (County)	Located in:	Oakfield Township	Corner Code #
1. Public Land Survey	T <u>9N</u>	R <u>9W</u>	<u>E-12</u>
	T _____	R _____	_____
	T _____	R _____	_____
	T _____	R _____	_____
2. Property Controlling in Section	S _____	T _____	R _____
	S _____	T _____	R _____
3. Miscellaneous Property in Sec.	S _____	T _____	R _____
	S _____	T _____	R _____

REG. OF DEEDS

*[Signature]*

1999 OCT 27 AM 8:38

STATE OF MICHIGAN  
COUNTY OF KENT  
RECEIVED FOR RECORD

11428

Register of Deeds Stamp & File Number


4. Lot No. \_\_\_\_\_, Recorded Plat \_\_\_\_\_  
5. Private Claims \_\_\_\_\_

I, Randy Kolehouse, in a field survey on March 12 19 99, do hereby certify that under requirements of P.A. 74 Michigan P.A. of 1970, the corner points mentioned in lines 1 and 2 above were in conformance with regulations and rules therefore as required in the current manual of survey instructions of the United States Department of the Interior, Bureau of Land Management or by a decree of a Court of Law and/or that the corner points mentioned in lines 3, 4 and 5 above were in conformance with the rules of the Michigan Board of Land Surveyors or by a Decree of a Court of Law; established, re-established, monumented, re-monumented, recovered, found as expressed below:

**NOTE: Not more than 4 corners, all in the same town and range, may be recorded on this certificate.**

A. Description of original monument and accessories and/or subsequent restoration:

E-12	1837	G.L.O. Notes	Cathcart	Set Post
	1934-63	Witness Map	K.C. Surveyor	Iron
	1975	L.C.R.C. #810	Exxel Engineering	1/2" Iron in Mon. Box
	1981	L.C.R.C. #1679	Williams & Works	Fnd. Iron in Mon. Box / Set K.C. Mon. in Mon. Box
	1989	L.C.R.C. #5200	John Bueche	K.C. Monument
	1997	L.C.R.C. #9668	Kirk Breitels	K.C. Monument

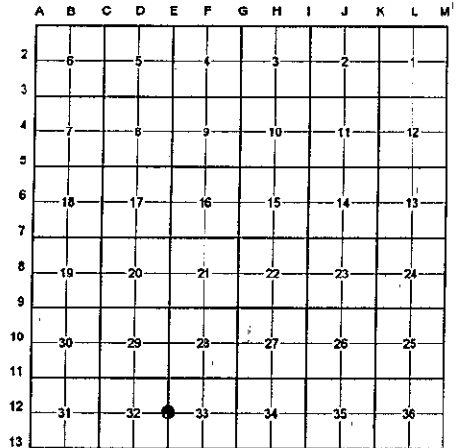

P.A. 345 1990 KENT COUNTY

PEER APPROVED 7/29/99

CHAIRMAN [Signature]

This corner was originally approved by the Kent County Remonumentation Peer Group and monumented by Williams & Works on 4/13/81 and was recorded per L.C.R.C. #1679.

B. Description of corner evidence found and/or method applied in restoring or reestablishing corner:

E-12 Found a Standard Kent County Monument in a monument box on the C/L of Hart Street (bit.) running East and West per L.C.R.C.'s #1679, #5200, and #9668 as set by Williams & Works in place of a 1-1/2" x 18" iron they found in a monument box which checked L.C.R.C. #810 and the K.C. Surveyor's records.

L.C.R.C. #1679

K.C. Remon. tag and nail in W side 18" Oak S.10°W. 47.90'  
SE cor conc fnd. to shed N.65°E. 53.66'  
SW cor conc fnd. to shed N.45°E. 40.15'  
Center line 12" Pine (no nail) N.50°W. 135.70'  
NE cor hse fnd #10385 N.20°W. 122.39'

L.C.R.C. #9668


Nail & KC Remon. tag W. side 26" Oak S10°W 47.84' (m. 47.85')  
Nail & KC Remon. tag SW side 20" Oak S45°E 90.30' (m. 90.28')  
SE corner porch fnd. #10385 N25°W 95.91' (m. 96.00')  
SE cor. conc. fnd. To shed N65°E 55.23'  
SE cor. conc. fnd. To shed N45°E 39.95' (39.93')

The selected location is accepted by me and is generally accepted by professional surveyors as the best available evidence of the position of the original corner.

C. Description of monument for corner and accessories established to perpetuate locating the position of the corner:

E-12 Standard Kent County Monument in a Monument Box

Nail & K.C. remon. tag on W side 26" Oak S 10° W 47.85'  
Nail & K.C. remon. tag on SW side 20" Oak S 45° E 90.28'  
SE cor. porch fndn. #10385 N 25° W 96.00'  
SE cor. conc. fndn. to shed N 65° E 55.23'  
SW cor. conc. fndn. to shed N 45° E 39.93'  
On C/L of bit. road running E-W

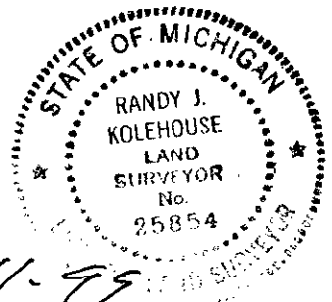

Signed by Randy J. Kolehouse Date 10-11-99

WILLIAMS & WORKS

Surveyor's Michigan License No. 25854