

MAY 28 2000

\$7.00
\$2.00

SECTION

LAND CORNER RECORDATION CERTIFICATE
Filing Requirement of Act 74, Mich. P.A. 1970
KENT COUNTY REMONUMENTATION

For corners in

Kent (County)	Located in: Oakfield Township	Corner Code #
1. Public Land Survey	T 9N R 9W	F-1
	T R	
	T R	
	T R	
2. Property Controlling in Section	S T R	
	S T R	
3. Miscellaneous Property in Sec.	S T R	
	S T R	

REG. OF DEEDS

[Signature]

STATE OF MICHIGAN
COUNTY OF KENT
RECEIVED FOR RECORD
1999 DEC - 8 AM 10:06

11547

Register of Deeds Stamp & File Number

- 4. Lot No. _____, Recorded Plat _____
- 5. Private Claims _____

I, Randy Kolehouse, in a field survey on September 1 19 99, do hereby certify that under requirements of P.A. 74 Michigan P.A. of 1970, the corner points mentioned in lines 1 and 2 above were in conformance with regulations and rules therefore as required in the current manual of survey instructions of the United States Department of the Interior, Bureau of Land Management or by a decree of a Court of Law and/or that the corner points mentioned in lines 3, 4 and 5 above were in conformance with the rules of the Michigan Board of Land Surveyors or by a Decree of a Court of Law; established, re-established, monumented, re-monumented, recovered, found as expressed below:

NOTE: Not more than 4 corners, all in the same town and range, may be recorded on this certificate.

- A. Description of original monument and accessories and/or subsequent restoration:
- F-1 This corner was not originally set by the G.L.O.

1983	L.C.R.C. #3328	Glaza & Associates	5/8" Rod
1984	L.C.R.C. #4001	John Bueche	Fnd. Rerod / Set K.C. Monument
1992	L.C.R.C. #6430	John Bueche	K.C. Monument

Note: This corner is not common with F-13, T10N, R9W.

This corner was originally approved by the Kent County Remonumentation Peer Group and monumented by John Bueche on 10/17/84 and was recorded per L.C.R.C. #4001.

- B. Description of corner evidence found and/or method applied in restoring or reestablishing corner:

F-1 Found a Standard Kent County Monument 4' ± South of the C/L of 16 Mile Road (gravel) running East and West and 148' ± West of the C/L of Sand Hill Avenue extended (gravel) running North per L.C.R.C.'s #4001 and #6430 as set by John Bueche on the South line of Section 4 in place of a rerod he found which checked L.C.R.C. #3328.

L.C.R.C. #4001

L.C.R.C. #6430

K.C. Remon. tag & nail in E. side 10" Oak S 60° W 43.63'
K.C. Remon. tag & nail in W. side 12" Oak N 5° W 49.60'
K.C. Remon. tag & nail in S. side 10" Wild Cherry S 70° E 46.85'
On C/L gravel road E-W

K.C. Remon. Tag & Nail SW side 12" Oak N 45° E 48.37' (m. 48.42')
K.C. Remon. Tag & Nail SW side 12" Oak N 50° W 58.50' (m. 58.46')
K.C. Remon. Tag & Nail E side 12" Oak S 60° W 43.63' (m. 43.59')
K.C. Remon. Tag & Nail W side 14" Oak N 05° W 49.60' (m. 49.71')
K.C. Remon. Tag & Nail S side 10" Oak S 70° E 46.85'
K.C. Mon. (S 1/4 33, 10-9) East 148.67' (m. 148.69')

The selected location is accepted by me and is generally accepted by professional surveyors as the best available evidence of the position of the original corner.

- C. Description of monument for corner and accessories established to perpetuate locating the position of the corner:



F-1 Standard Kent County Monument

- Nail & K.C. remon. tag on SW side 14" Oak N 45° E 48.42'
- Nail & K.C. remon. tag on SW side 14" Oak N 50° W 58.46'
- Nail & K.C. remon. tag on E side 12" Oak S 60° W 43.59'
- Nail & K.C. remon. tag on W side 14" Oak N 05° W 49.71'
- Nail & K.C. remon. tag on S side 12" Oak (stump) S 70° E 46.85'
- C/L of gravel road running E-W, North 4' ±
- C/L of extended gravel road running N, East 148' ±
- K.C. Mon., F-13, T10N, R9W, East 148.69'

Signed by *Randy Kolehouse* Date _____

WILLIAMS & WORKS

Surveyor's Michigan License No. 25854

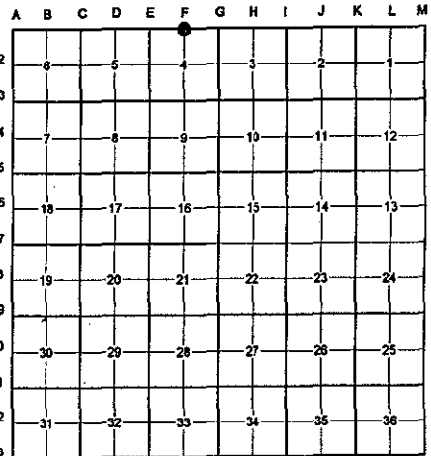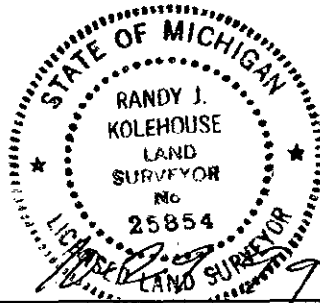

P.A. 345 1990 KENT COUNTY

PEER APPROVED 10/28/99
CHAIRMAN *[Signature]*