

SURVEY &
REMONUMENTATION

\$7.00
\$2.00

MAY 22 2000

LAND CORNER RECORDATION CERTIFICATE
Filing Requirement of Act 74, Mich. P.A. 1970
KENT COUNTY REMONUMENTATION

For corners in

SECTION

Kent (County)	Located in:	Oakfield Township	Corner Code #
1. Public Land Survey	T <u>9N</u>	R <u>9W</u>	<u>F-3</u>
	T _____	R _____	_____
	T _____	R _____	_____
	T _____	R _____	_____
2. Property Controlling in Section	S _____	T _____	R _____
	S _____	T _____	R _____
3. Miscellaneous Property in Sec.	S _____	T _____	R _____
	S _____	T _____	R _____

1999 OCT 27 AM 8:38
STATE OF MICHIGAN
COUNTY OF KENT
RECEIVED FOR RECORD

REG. OF DEEDS
[Signature]


11429

Register of Deeds Stamp & File Number

4. Lot No. _____, Recorded Plat _____
5. Private Claims _____

I, Randy Kolehouse, in a field survey on March 22 19 99, do hereby certify that under requirements of P.A. 74 Michigan P.A. of 1970, the corner points mentioned in lines 1 and 2 above were in conformance with regulations and rules therefore as required in the current manual of survey instructions of the United States Department of the interior, Bureau of Land Management or by a decree of a Court of Law and/or that the corner points mentioned in lines 3, 4 and 5 above were in conformance with the rules of the Michigan Board of Land Surveyors or by a Decree of a Court of Law; established, re-established, monumented, re-monumented, recovered, found as expressed below:

NOTE: Not more than 4 corners, all in the same town and range, may be recorded on this certificate.

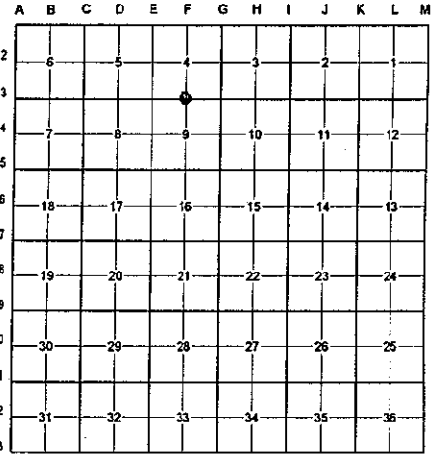

A. Description of original monument and accessories and/or subsequent restoration:

F-3	1837	G.L.O. Notes	Cathcart	Set Post
	N/A	Witness Map	K.C. Surveyor	Stake & Iron
	1981	L.C.R.C. #2087	Nederveld & Jonker	3/4" Round Iron
	1982	L.C.R.C. #2871	Jonker Land Surveys	Fnd. Iron / Set K.C. Monument
	1989	L.C.R.C. #5202	John Bueche	K.C. Monument
	1997	L.C.R.C. #9670	Kirk Breitels	K.C. Monument

P.A. 345 1990 KENT COUNTY
PEER APPROVED 7/29/99
CHAIRMAN [Signature]

This corner was originally approved by the Kent County Remonumentation Peer Group and monumented by Rob Jonker on 5/25/82 and was recorded per L.C.R.C. #2871.

B. Description of corner evidence found and/or method applied in restoring or reestablishing corner:

F-3 Found a Standard Kent County Monument on the West side of an old logging road running North and South, on line of a downed fence line running North and South, per L.C.R.C.'s #2871, #5202, and #9670 as set by Rob Jonker in place of 1-3/4" round iron he found which checked L.C.R.C. #2087 and K.C. Surveyor's records.

L.C.R.C. #2871

L.C.R.C. #9670

Remon. tag on S side 9" Tw. Maple S85°E 25.06'

Nail & KC remon. tag S. side 12" Tw. Maple S85°E 25.13'

Remon. tag on NW side 9" Tw. Maple N45°E 31.89'

Nail & KC Remon. tag NW side 12" & 20" Maple N45°E 31.80' (m. 31.78')

Remon. tag on E side 20" Maple N05°W 33.53'

Nail & KC remon. tag E. side 26" Maple N05°W 33.53' (m. 33.52')

Remon. tag on S side 16" Oak N80°W 14.76'

Nail & KC Remon. tag S. side 22" Oak N80°W 14.70' (m. 14.66')

On old N-S fence & tree line

On W. edge old N-S logging trail

The selected location is accepted by me and is generally accepted by professional surveyors as the best available evidence of the position of the original corner.

C. Description of monument for corner and accessories established to perpetuate locating the position of the corner:

F-3 Standard Kent County Monument

Nail & K.C. remon. tag on S side 12" twin Maple S 85° E 25.13'

Nail & K.C. remon. tag on NW side 12" & 20" Maple N 45° E 31.78'

Nail & K.C. remon. tag on E side 26" Maple N 05° W 33.52'


Nail & K.C. remon. tag on S side 22" Oak N 80° W 14.66'

Nail & K.C. remon. tag on W side 16" Maple N 22° W 13.08'

Nail & K.C. remon. tag on W side 12" Oak S 36° W 12.27'

On downed fence line running N-S

On W edge of old logging road running N-S

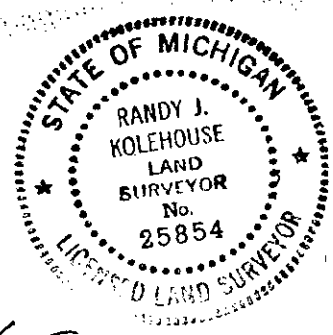

Signed by Randy J. Kolehouse
WILLIAMS & WORKS

Date 10-11-99

Surveyor's Michigan License No. 25854