

SURVEY & REMONUMENTATION  
 \$7.00  
 \$2.00  
 MAY 22 2000

LAND CORNER RECORDATION CERTIFICATE  
 Filing Requirement of Act 74, Mich. P.A. 1970  
 KENT COUNTY REMONUMENTATION

SECTION

For corners in Kent (County) Located in: Oakfield Township Corner Code #


1. Public Land Survey	T 9N	R 9W	F-5
	T	R	
	T	R	
	T	R	
2. Property Controlling in Section	S	T	R
	S	T	R
3. Miscellaneous Property in Sec.	S	T	R
	S	T	R

4. Lot No. \_\_\_\_\_, Recorded Plat \_\_\_\_\_

5. Private Claims \_\_\_\_\_

STATE OF MICHIGAN  
 COUNTY OF KENT  
 RECEIVED FOR RECORD  
 1999 DEC - 8 AM 10:06  
 REG. OF DEEDS  
 11548  
 Register of Deeds Stamp & File Number

I, Randy Kolehouse, in a field survey on October 5 19 99, do hereby certify that under requirements of P.A. 74 Michigan P.A. of 1970, the corner points mentioned in lines 1 and 2 above were in conformance with regulations and rules therefore as required in the current manual of survey instructions of the United States Department of the Interior, Bureau of Land Management or by a decree of a Court of Law and/or that the corner points mentioned in lines 3, 4 and 5 above were in conformance with the rules of the Michigan Board of Land Surveyors or by a Decree of a Court of Law; established, re-established, monumented, re-monumented, recovered, found as expressed below:

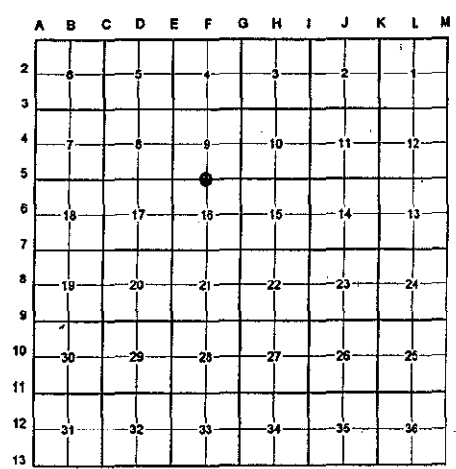

NOTE: Not more than 4 corners, all in the same town and range, may be recorded on this certificate.

A. Description of original monument and accessories and/or subsequent restoration:

F-5	1837	G.L.O. Notes	Cathcart	Set Post
	1963	Witness Map	K.C. Surveyor	3/4" Iron
	1983	Records	All Points	Rerod in Monument Box
	1992	L.C.R.C. #6585	John Bueche	Fnd. Rerod in Mon. Box / Set K.C. Monument
	1997	L.C.R.C. #9671	Kirk Breitels	K.C. Monument

P.A. 345 1990 KENT COUNTY  
 PEER APPROVED 10/28/99  
 CHAIRMAN Randy Kolehouse

This corner was originally approved by the Kent County Remonumentation Peer Group and monumented by John Bueche in August 1992 and was recorded per L.C.R.C. #6585.

B. Description of corner evidence found and/or method applied in restoring or reestablishing corner:

F-5 Found a Standard Kent County Monument 10' ± South of the C/L of 14 Mile Road (bit.) running East and West and 6' ± West of the C/L of Wellman Avenue (gravel) running South per L.C.R.C.'s #6585 and #9671 as set by John Bueche in place of a rerod he found in a monument box which checked the 1983 All Points' records and the K.C. Surveyor's records.

L.C.R.C. #6585

- Nail & K.C. Remon. Tag W side of PP N 40° W 72.92'
- Nail & K.C. Remon. Tag top of cut off pole near MBT box N 40° E 92.80'
- Nail & K.C. Remon. Tag curb joint S 55° E 41.35'
- PK in joint of curb S 35° W 30.08'
- C/L M-57 North 9.88'+/-
- C/L gravel road South, West 6'+/-

L.C.R.C. #9671


- Nail & KC Remon. Tag W. side (4' high) P. Pole N40°W 72.92' (m. 72.94')
- Nail & KC Remon. Tag top of cut off pole N40°E 92.80' (m. 92.88')
- Nail & KC Remon. Tag in curb joint S55°E 41.28' (m. 41.03')
- PK Nail in curb joint S36°W 30.03' (m. 30.09')
- C/L M-57 is North 9.88'+/-
- C/L gravel road South is East 6'+/-

The selected location is accepted by me and is generally accepted by professional surveyors as the best available evidence of the position of the original corner.

C. Description of monument for corner and accessories established to perpetuate locating the position of the corner:

F-5 Standard Kent County Monument

- Nail & K.C. remon. tag on W side P. pole (4' high) N 40° W 72.94'
- Nail & K.C. remon. tag on top cut off pole N 40° E 92.88'
- PK in curb joint S 55° E 41.03'
- PK in curb joint S 36° W 30.09'
- C/L of bit. road running E-W, North 10'
- C/L of gravel road running S, East 6' ±

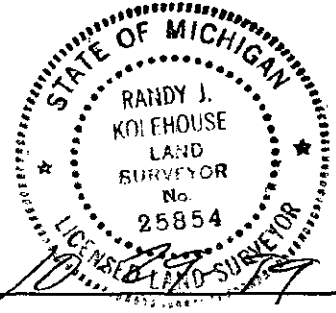

Signed by Randy J. Kolehouse  
 WILLIAMS & WORKS

Date 10/28/99

Surveyor's Michigan License No. 25854