

\$7.00  
\$2.00

MAY 22 2000

SECTION

LAND CORNER RECORDATION CERTIFICATE  
Filing Requirement of Act 74, Mich. P.A. 1970  
KENT COUNTY REMONUMENTATION

For corners in

Kent (County)	Located in: Oakfield Township	Corner Code #
1. Public Land Survey	T <u>9N</u> R <u>9W</u>	<u>F-6</u>
	T _____ R _____	_____
	T _____ R _____	_____
	T _____ R _____	_____
2. Property Controlling in Section	S _____ T _____ R _____	_____
	S _____ T _____ R _____	_____
3. Miscellaneous Property in Sec.	S _____ T _____ R _____	_____
	S _____ T _____ R _____	_____
4. Lot No. _____, Recorded Plat _____		
5. Private Claims _____		

REG. OF DEEDS

*[Signature]*

STATE OF MICHIGAN  
COUNTY OF KENT  
RECEIVED FOR RECORD  
1999 DEC 27 AM 8:19

11639


Register of Deeds Stamp & File Number

I, Randy Kolehouse, in a field survey on March 22 19 99, do hereby certify that under requirements of P.A. 74 Michigan P.A. of 1970, the corner points mentioned in lines 1 and 2 above were in conformance with regulations and rules therefore as required in the current manual of survey instructions of the United States Department of the interior, Bureau of Land Management or by a decree of a Court of Law and/or that the corner points mentioned in lines 3, 4 and 5 above were in conformance with the rules of the Michigan Board of Land Surveyors or by a Decree of a Court of Law; established, re-established, monumented, re-monumented, recovered, found as expressed below:

NOTE: Not more than 4 corners, all in the same town and range, may be recorded on this certificate.

A. Description of original monument and accessories and/or subsequent restoration:

F-6	This corner was not originally set by the G.L.O.		
1963	Witness Map	K.C. Surveyor	1 1/4" Iron Pipe
1979	L.C.R.C. #1261	Exxel Engineering	1 1/4" Iron
1992	L.C.R.C. #6586	John Bueche	Fnd. Iron - Set K.C. Monument
1997	L.C.R.C. #9672	Kirk Breitels	K.C. Monument

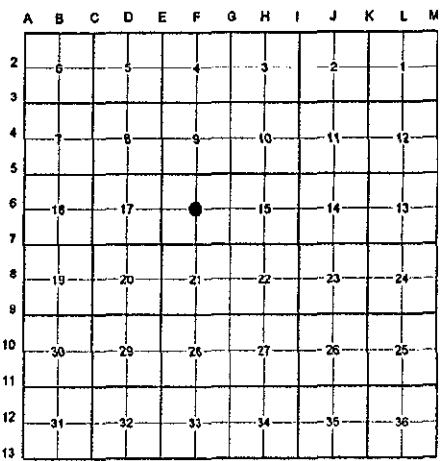

P.A. 345 1990 KENT COUNTY  
PEER APPROVED 7/29/99  
CHAIRMAN *[Signature]*

B. Description of corner evidence found and/or method applied in restoring or reestablishing corner:

F-6 Found a Standard Kent County Monument 5' ± West of the C/L of Wellman Avenue (gravel) running North and South, 5' ± South of Stultz Street (gravel) running East, and 2' ± South of a fence line and tree row running West per L.C.R.C.'s #6586 and #9672 as set by John Bueche in place of an iron he found which checked L.C.R.C. #1261 and the K.C. Surveyor's records. Monument is 13.1' North and 13.4' East of the intersection of 1/4 lines. Accepted Monument as Center of Section.

L.C.R.C. #6586

L.C.R.C. #9672


- Nail & K.C. Remon. Tag E side root 30" Maple S 20° W 85.75'
- Nail & K.C. Remon. Tag W side 24" Maple N 15° E 101.37'
- Nail & K.C. Remon. Tag N side 24" Maple N 65° E 62.27'
- Nail & K.C. Remon. Tag S side 24" Maple N 80° E 141.21'
- C/L gravel N-S, East 5' +/-
- C/L gravel E, North 5'
- PK in N side PP N 80° W. 28.10'

- Nail & KC Remon. tag E. side 32" Maple S20°W 86.32' (m. 86.28')
- Nail & KC Remon. tag W. side 24' Maple N15°E 101.42' (m. 101.35')
- Nail & KC Remon. tag N. side 26" Maple N65°E 62.31' (m. 62.27')
- Nail & KC Remon. tag S. side 26" Maple N80°E 141.21' (m. 141.19')
- PK in N. side Power Pole N80°W 28.10' (m. 28.04')
- Nail & KC Remon. tag W. side Power Pole S20°E 112.20'
- C/L gravel N-S, East 5' +/-, C/L gravel E, North 5'+/-

The selected location is accepted by me and is generally accepted by professional surveyors as the best available evidence of the position of the original corner.

C. Description of monument for corner and accessories established to perpetuate locating the position of the corner:

- F-6 Standard Kent County Monument
- Nail & K.C. remon. tag on E side 32" Maple S 20° W 86.28'
- Nail & K.C. remon. tag on W side 24" Maple N 15° E 101.35'
- Nail & K.C. remon. tag on N side 26" Maple N 65° E 62.27'
- Nail & K.C. remon. tag on S side 26" Maple N 80° E 141.19'
- Nail & K.C. remon. tag on W side P. pole S 20° E 112.20'
- Nail & K.C. remon. tag on N side P. pole N 80° W 28.04'

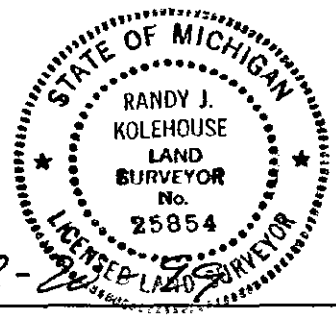

Signed by Randy J. Kolehouse Date 12-29-99

WILLIAMS & WORKS

Surveyor's Michigan License No. 25854