

\$7.00
\$2.00

MAY 22 2000

LAND CORNER RECORDATION CERTIFICATE
Filing Requirement of Act 74, Mich. P.A. 1970
KENT COUNTY REMONUMENTATION

STATE OF MICHIGAN
COUNTY OF KENT
RECEIVED FOR RECORD
1999 OCT 27 AM 8:38

REG. OF DEEDS

[Handwritten Signature]

11431

Register of Deeds Stamp & File Number

For corners in

SECTION

Kent (County)	Located in:	Oakfield Township	Corner Code #
1. Public Land Survey	T <u>9N</u>	R <u>9W</u>	<u>F-9</u>
	T _____	R _____	_____
	T _____	R _____	_____
	T _____	R _____	_____
2. Property Controlling in Section	S _____	T _____	R _____
	S _____	T _____	R _____
3. Miscellaneous Property in Sec.	S _____	T _____	R _____
	S _____	T _____	R _____

4. Lot No. _____, Recorded Plat _____
5. Private Claims _____


I, Randy Kolehouse, in a field survey on March 22 19 99, do hereby certify that under requirements of P.A. 74 Michigan P.A. of 1970, the corner points mentioned in lines 1 and 2 above were in conformance with regulations and rules therefore as required in the current manual of survey instructions of the United States Department of the Interior, Bureau of Land Management or by a decree of a Court of Law and/or that the corner points mentioned in lines 3, 4 and 5 above were in conformance with the rules of the Michigan Board of Land Surveyors or by a Decree of a Court of Law; established, re-established, monumented, re-monumented, recovered, found as expressed below:

NOTE: Not more than 4 corners, all in the same town and range, may be recorded on this certificate.

A. Description of original monument and accessories and/or subsequent restoration:

F-9	1837	G.L.O. Notes	Cathcart	Set Post
	1940	Witness Map	K.C. Surveyor	Monument
	1983	L.C.R.C. #3570	William Byl	Fnd. Conc. Mon. / Set K.C. Monument
	1989	L.C.R.C. #5204	John Bueche	K.C. Monument
	1997	L.C.R.C. #9674	Kirk Breitels	K.C. Monument

P.A. 345 1990 KENT COUNTY
PEER APPROVED 7/29/99
CHAIRMAN [Signature]

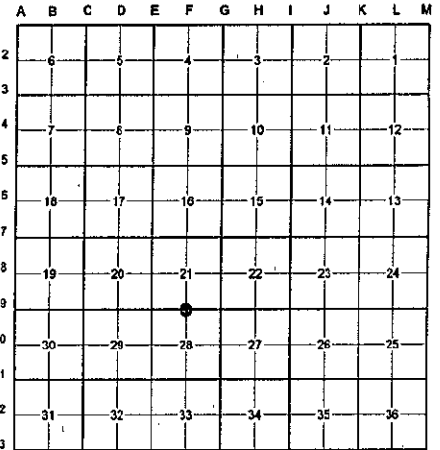

This corner was originally approved by the Kent County Remonumentation Peer Group and monumented by William Byl on 8/30/83 and was recorded per L.C.R.C. #3570.

B. Description of corner evidence found and/or method applied in restoring or reestablishing corner:

F-9 Found a Standard Kent County Monument on the C/L of Wellman Avenue (gravel) running North, on a tree row running East, per L.C.R.C.'s #3570, #5204, and #9674 as set by William Byl over a concrete monument he found 24" below the road's surface which checked the K.C. Surveyor's records.

L.C.R.C. #3570

L.C.R.C. #9674

Nail & tag, S sd. Transformer pole N 90° E 25.74'
Nail & tag, N sd. 8" Oak N 50° W 74.32'
NW cor. Garage fnd. S 50° E 140.45'
"T" iron N 90° E 32.98'


Nail & KC Remon. tag S. side Transformer Pole N90°E 25.74'
Nail & KC Remon. tag N. side 14" Oak N50°W 74.26' (m. 74.24')
NW corner garage fnd. S50°E 140.45' (m. 140.37')
Cor. is at the S. end of C/L grav. Rd. and on W. edge grav. Dr. S.

The selected location is accepted by me and is generally accepted by professional surveyors as the best available evidence of the position of the original corner.

C. Description of monument for corner and accessories established to perpetuate locating the position of the corner:

F-9 Standard Kent County Monument

Nail & K.C. remon. tag on S side Transformer pole N 90° E 25.74'
Nail & K.C. remon. tag on N side 14" Oak N 50° W 74.24'
Nail & K.C. remon. tag on E side P. pole N 08° E 184.33'
Nail & K.C. remon. tag on S side 24" Maple S 60° W 108.26'
NW cor. gar. fndn. S 50° E 140.37'
"T" iron N 90° E 32.98'
On C/L of gravel road running N
On tree row running E

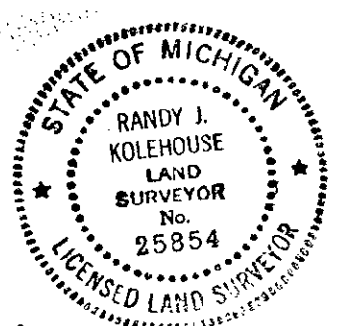

Signed by [Signature] Date 10-11-99
WILLIAMS & WORKS

Surveyor's Michigan License No. 25854