

MAY 22 2000

SECTION

LAND CORNER RECORDATION CERTIFICATE
Filing Requirement of Act 74, Mich. P.A. 1970
KENT COUNTY REMONUMENTATION

For corners in

Kent
(County)

Located in: Oakfield
Township

Corner Code #

1. Public Land Survey	T <u>9N</u>	R <u>9W</u>	<u>F-11</u>
	T _____	R _____	_____
	T _____	R _____	_____
	T _____	R _____	_____
2. Property Controlling in Section	S _____	T _____	R _____
	S _____	T _____	R _____
3. Miscellaneous Property in Sec.	S _____	T _____	R _____
	S _____	T _____	R _____

REG. OF DEEDS


[Signature]

STATE OF MICHIGAN
COUNTY OF KENT
RECEIVED FOR RECORD
1999 OCT 27 AM 8:38

11432

Register of Deeds Stamp & File Number

4. Lot No. _____, Recorded Plat _____
5. Private Claims _____

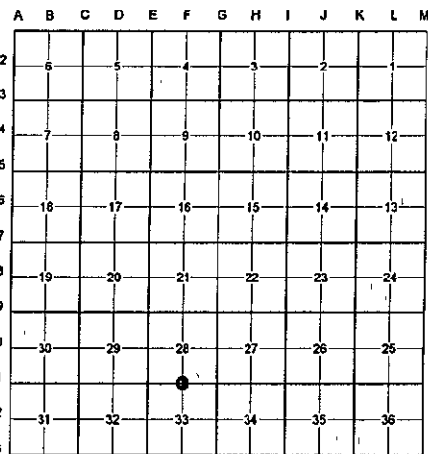

I, Randy Kolehouse, in a field survey on March 25 19 99, do hereby certify that under requirements of P.A. 74 Michigan P.A. of 1970, the corner points mentioned in lines 1 and 2 above were in conformance with regulations and rules therefore as required in the current manual of survey instructions of the United States Department of the Interior, Bureau of Land Management or by a decree of a Court of Law and/or that the corner points mentioned in lines 3, 4 and 5 above were in conformance with the rules of the Michigan Board of Land Surveyors or by a Decree of a Court of Law; established, re-established, monumented, re-monumented, recovered, found as expressed below:

NOTE: Not more than 4 corners, all in the same town and range, may be recorded on this certificate.

A. Description of original monument and accessories and/or subsequent restoration:

F-11	1837	G.L.O. Notes	Cathcart	Set Post
	1983	L.C.R.C. #3572	William Byl	Fnd. Stones / Set K.C. Monument Over Stones
	1989	L.C.R.C. #5205	John Bueche	K.C. Monument
	1997	L.C.R.C. #9676	Kirk Breitels	K.C. Monument

This corner was originally approved by the Kent County Remonumentation Peer Group and monumented by William Byl on 9/13/83 and was recorded per L.C.R.C. #3572.

B. Description of corner evidence found and/or method applied in restoring or reestablishing corner:

F-11 Found a Standard Kent County Monument (in a ring of stones) on line of a downed fence line running North and South and 550' ± West of the C/L of Whitenbach Road running North and South per L.C.R.C.'s #3572, #5205, and #9676 as set by William Byl who found a 12" x 18" oval stone over the top of a 12" x 12" x 18" rectangular stone, over the top of a 12" round stone (30" deep).

L.C.R.C. #3572

L.C.R.C. #9676

Nail & tag, S sd. 6" Hickory N 85 W 51.10'
Nail & tag, N sd. 12" Cherry N 65 W 36.78'
Nail & tag, W sd. 30" Oak n 20 W 30.29'
Nail & tag, S sd. 24" Oak S 75 W 33.99'
C/L Wittenbah Rd. East 550'+/-

Nail & KC Remon. tag S. side 8" Hickory N85°W 51.16' (m. 51.13')
Nail & K Remon. tag W. side 36" Oak N20°W 30.29' (m. 30.32')
Nail & KC Remon. tag S. side 30" Oak S75°W 33.90' (m. 33.88')
Nail & KC Remon. tag N. side 16" Cherry N65°W 37.04' (m. 37.02')
C/L Wittenbah Rd. is East 550'+/-
On fence line extended West and on N-S tree row

The selected location is accepted by me and is generally accepted by professional surveyors as the best available evidence of the position of the original corner.

C. Description of monument for corner and accessories established to perpetuate locating the position of the corner:


F-11 Standard Kent County Monument

Nail & K.C. remon. tag on S side 8" Hickory N 85° W 51.13'
Nail & K.C. remon. tag on W side 36" Oak N 20° W 30.32'
Nail & K.C. remon. tag on S side 30" Oak S 75° W 33.88'
Nail & K.C. remon. tag on N side 16" Cherry N 65° W 37.02'
On downed fence line running N-S

P.A. 345 1999 KENT COUNTY

PEER APPROVED 7/29/99

CHAIRMAN *[Signature]*

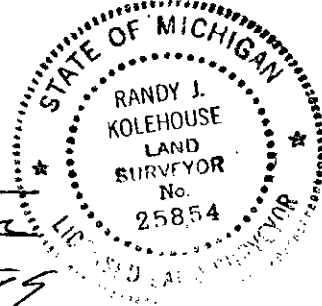

Signed by *[Signature]* Date 10-11-99

WILLIAMS & WORKS

Surveyor's Michigan License No. 25854