

SURVEY &
RECORDS

\$7.00
\$2.00

MAY 22 2000

LAND CORNER RECORDATION CERTIFICATE
Filing Requirement of Act 74, Mich. P.A. 1970
KENT COUNTY REMONUMENTATION

STATE OF MICHIGAN
COUNTY OF KENT
RECEIVED FOR RECORD
1999 DEC 27 AM 8:19

For corners in Kent (County) SECTION _____ Located in: Oakfield Township Corner Code # _____

1. Public Land Survey T 9N R 9W F-12
 T _____ R _____
 T _____ R _____
 T _____ R _____

2. Property Controlling in Section S _____ T _____ R _____
 S _____ T _____ R _____

3. Miscellaneous Property in Sec. S _____ T _____ R _____
 S _____ T _____ R _____

4. Lot No. _____, Recorded Plat _____

5. Private Claims _____

REG. OF DEEDS
[Signature]

11641

Register of Deeds Stamp & File Number

I, Randy Kolehouse, in a field survey on March 15 19 99, do hereby certify that under requirements of P.A. 74 Michigan P.A. of 1970, the corner points mentioned in lines 1 and 2 above were in conformance with regulations and rules therefore as required in the current manual of survey instructions of the United States Department of the interior, Bureau of Land Management or by a decree of a Court of Law and/or that the corner points mentioned in lines 3, 4 and 5 above were in conformance with the rules of the Michigan Board of Land Surveyors or by a Decree of a Court of Law; established, re-established, monumented, re-monumented, recovered, found as expressed below:


NOTE: Not more than 4 corners, all in the same town and range, may be recorded on this certificate.

A. Description of original monument and accessories and/or subsequent restoration:

F-12 This corner was not originally set by the G.L.O.

1934	Witness Map	K.C. Surveyor	3/4" Iron in Mon. Box
1973	L.C.R.C. #363	Exxel Engineering	3/4" Iron
1973	L.C.R.C. #369	Exxel Engineering	3/4" Iron
1977	L.C.R.C. #1078	John McCloskey	Iron

P.A. 345 1990 KENT COUNTY
PEER APPROVED 6/24/99
CHAIRMAN [Signature]

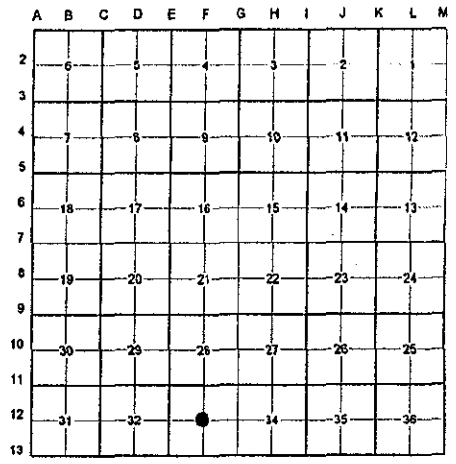

B. Description of corner evidence found and/or method applied in restoring or reestablishing corner:

F-12 Found a 1" iron pipe in a monument box on the C/L of Hart Road (bit.) running East and West, on line of a tree row running North and South, per L.C.R.C.'s # 363, #369, #1078 and the K.C. Surveyor's records. Iron is 0.2' North and 2.7' West of the intersection of 1/4 lines. Accepted iron as Center of Section.

L.C.R.C. #369
SW corner hse fnd. NE 57.25'
Nail in side 8" Wild Cherry NW 54.48'


L.C.R.C. #1078
Nail in 8" Cherry NW 54.48' (m. 55.18')

The selected location is accepted by me and is generally accepted by professional surveyors as the best available evidence of the position of the original corner.

C. Description of monument for corner and accessories established to perpetuate locating the position of the corner:

F-12 Replaced Iron with a Standard Kent County Monument in an Existing Monument Box

- Nail & K.C. remon. tag on NE side 8" W. Cherry N 55° W 55.18'
- SW cor. hse. fndn. #11605 N 30° E 57.20'
- Nail & K.C. remon. tag on W side 28" Maple N 02° W 36.46'
- Nail & K.C. remon. tag on SW side P. pole S 40° E 246.60'
- Nail & K.C. remon. tag on N side 20" Hickory S 75° E 229.88'
- On C/L of bit. road running E-W
- On tree row running N-S

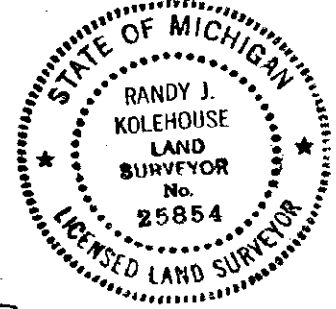

Signed by Randy J. Kolehouse Date 12-20-99
WILLIAMS & WORKS
Surveyor's Michigan License No. 25854