

**SURVEY & REMONUMENTATION**

\$7.00  
\$2.00

MAR 08 1999

**LAND CORNER RECORDATION CERTIFICATE**  
**Filing Requirement of Act 74, Mich. P.A. 1970**  
**KENT COUNTY REMONUMENTATION**

For corners in

**SECTION**

Kent (County)	Located in:	Oakfield Township	Corner Code #
1. Public Land Survey	T <u>9N</u>	R <u>9W</u>	<u>F-13</u>
	T _____	R _____	_____
	T _____	R _____	_____
	T _____	R _____	_____
2. Property Controlling in Section	S _____	T _____	R _____
	S _____	T _____	R _____
3. Miscellaneous Property in Sec.	S _____	T _____	R _____
	S _____	T _____	R _____


STATE OF MICHIGAN  
COUNTY OF KENT  
RECEIVED FOR RECORD  
38 DEC 14 AM 8:00  
REG. OF DEEDS  
*Lucy Standa*

**11014**

Register of Deeds Stamp & File Number

4. Lot No. \_\_\_\_\_, Recorded Plat \_\_\_\_\_  
5. Private Claims \_\_\_\_\_

I, Randy Kolehouse, in a field survey on December 3 19 98, do hereby certify that under requirements of P.A. 74 Michigan P.A. of 1970, the corner points mentioned in lines 1 and 2 above were in conformance with regulations and rules therefore as required in the current manual of survey instructions of the United States Department of the interior, Bureau of Land Management or by a decree of a Court of Law and/or that the corner points mentioned in lines 3, 4 and 5 above were in conformance with the rules of the Michigan Board of Land Surveyors or by a Decree of a Court of Law; established, re-established, monumented, re-monumented, recovered, found as expressed below:

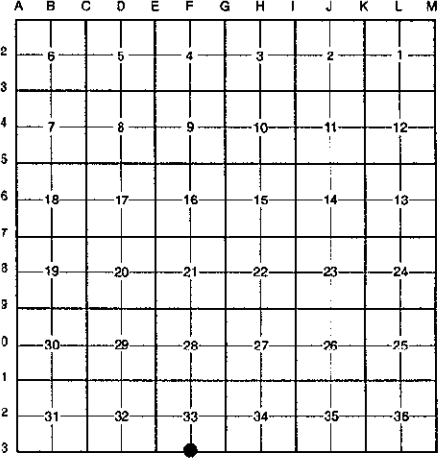

**NOTE: Not more than 4 corners, all in the same town and range, may be recorded on this certificate.**

**A. Description of original monument and accessories and/or subsequent restoration:**

F-13 - 1837	G.L.O. Notes	N. Brookfield	Set Post	P.A. 345 1990 KENT COUNTY
1934	Witness Map	K.C. Surveyor	Iron & Stone	PEER APPROVED <u>9/24/98</u>
1972	L.C.R.C. #363	Exxel Engineering	1" Iron in Mon. Box	CHAIRMAN <u>Randy Kolehouse</u>
1973	L.C.R.C. #369	Exxel Engineering	1" Iron	
1981	L.C.R.C. #1728	Williams & Works	Fnd. 1" Iron in Mon. Box / Set K.C. Monument	
1989	L.C.R.C. #5206	John Bueche	K.C. Monument in Monument Box	
1997	L.C.R.C. #9677	Kirk Breitels	K.C. Monument in Monument Box	

Note: This corner is not common with F-1, T8N, R9W.

This corner was originally approved by the Kent County Remonumentation Peer Group and monumented by Williams & Works on 12/22/80 and was recorded per L.C.R.C. #1728.

**B. Description of corner evidence found and/or method applied in restoring or reestablishing corner:**

F-13 Found a Standard Kent County Monument in a monument box on the C/L of 10 Mile Road (bit.) running East and West on line of a fence row running North per L.C.R.C.'s #1728, #5206 and #9677 as set by Williams & Works in place of a 1" iron they found in a monument box which checked L.C.R.C.'s #369, #363 and the K.C. Surveyor's records.

L.C.R.C. #1728

L.C.R.C. #9677

K.C. Remon. Tag & Nail in SE Side P. Pole S 40°W 177.79'	Nail & KC Remon. tag E. side cor. Fc. Post N00°E 33.51' (m. 33.16')
K.C. Remon. Tag & Nail in E Side Cor. Fe. Post n 00°E 33.63'	Nail & KC Remon. tag E. side Tri. 6" Cherry S10°E 39.02' (m. 38.98')
"X" Cut on Top of Culvert S 70°E 112.05'	Nail & KC Remon. tag E. side Tw. 6" Cherry S25°W 42.45' (m. 42.42')
"X" Cut on Top of Culvert S 75°E 135.52'	"X" cut on top of culvert S70°E 112.00'
	"X" cut on top of culvert S75°E 135.47' (m. 135.43')
	K.C. Mon. (F-1, T8N, R9W) West 146.05' (m. 146.00')


The selected location is accepted by me and is generally accepted by professional surveyors as the best available evidence of the position of the original corner.

**C. Description of monument for corner and accessories established to perpetuate locating the position of the corner:**

F-13 Standard Kent County Monument in a Monument Box

- Nail & K.C. remon. tag on E side cor. fence post N 00° E 33.16'
- Nail & K.C. remon. tag on E side tri. 6" Cherry S 10° E 38.98'
- Nail & K.C. remon. tag on E side tw. 6" Cherry S 25° W 42.42'
- "X" cut on top of conc. culvert S 70° E 112.00'
- "X" cut on top of conc. culvert S 75° E 135.43'

On C/L of bit. road running E-W  
On fence line running N  
K.C. Mon., F-1, T8N, R9W, West 146.05'

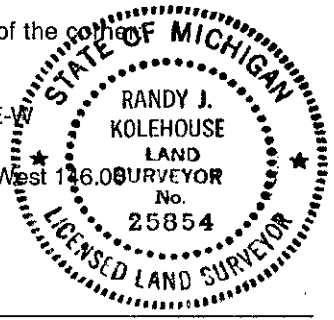

Signed by Randy J. Kolehouse Date 12/5/98  
EARTH TECH  
Surveyor's Michigan License No. 25854