

\$7.00
\$2.00

MAY 22 2000

SECTION

LAND CORNER RECORDATION CERTIFICATE
Filing Requirement of Act 74, Mich. P.A. 1970
KENT COUNTY REMONUMENTATION

STATE OF MICHIGAN
COUNTY OF KENT
RECEIVED FOR RECORD
1999 DEC - 8 AM 10: 06
REG. OF DEEDS

For corners in

Kent (County)	Located in: Oakfield Township	Corner Code #
1. Public Land Survey	T <u>9N</u> R <u>9W</u>	<u>G-1</u>
	T _____ R _____	_____
	T _____ R _____	_____
	T _____ R _____	_____
2. Property Controlling in Section	S _____ T _____ R _____	_____
	S _____ T _____ R _____	_____
3. Miscellaneous Property in Sec.	S _____ T _____ R _____	_____
	S _____ T _____ R _____	_____


11549

Register of Deeds Stamp & File Number

4. Lot No. _____, Recorded Plat _____
5. Private Claims _____

I, Randy Kolehouse, in a field survey on September 29 19 99, do hereby certify that under requirements of P.A. 74 Michigan P.A. of 1970, the corner points mentioned in lines 1 and 2 above were in conformance with regulations and rules therefore as required in the current manual of survey instructions of the United States Department of the interior, Bureau of Land Management or by a decree of a Court of Law and/or that the corner points mentioned in lines 3, 4 and 5 above were in conformance with the rules of the Michigan Board of Land Surveyors or by a Decree of a Court of Law; established, re-established, monumented, re-monumented, recovered, found as expressed below:

NOTE: Not more than 4 corners, all in the same town and range, may be recorded on this certificate.

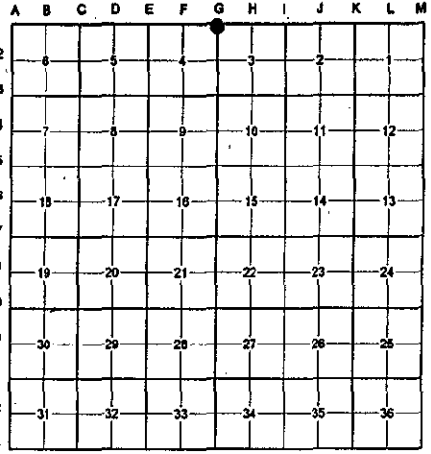

A. Description of original monument and accessories and/or subsequent restoration:

G-1	1837	G.L.O. Notes	Cathcart	Set Post
	1894	Notes	Williams & Works	Fnd. Stake / Set Stone & Iron
	1900	Notes	Williams & Works	Stake, Stone, & Iron
	1947	Notes	Williams & Works	Held Point
	1984	L.C.R.C. #4002	John Bueche	Fnd. Rebar / Set K.C. Monument
	1992	L.C.R.C. #6431	John Bueche	K.C. Monument

P.A. 345 1990 KENT COUNTY
PEER APPROVED 10/29/99
CHAIRMAN [Signature]

Note: This corner is not common with G-13, T10N, R9W.

This corner was originally approved by the Kent County Remonumentation Peer Group and monumented by John Bueche on 10/17/84 and was recorded per L.C.R.C. #4002.

B. Description of corner evidence found and/or method applied in restoring or reestablishing corner:

G-1 Found a Standard Kent County Monument on line of a tree row running East and West per L.C.R.C.'s #4002 and #6431 as set by John Bueche on the Township line, 1.67' North of a found iron.

L.C.R.C. #4002

L.C.R.C. #6431

K.C. Remon. tag & nail in S. side 12" Oak N 90° E 31.52'
K.C. Remon. tag & nail in NE side 10" Oak S 50° E 42.20'
K.C. Remon. tag & nail in E. side 8" Oak S 0° E 20.39'
K.C. Remon. tag & nail in S. side 12" Oak S 85° W 19.72'
Iron South 1.67'

K.C. Remon. Tag & Nail S side 14" Oak S 90° E 31.52' (m. 31.51')
K.C. Remon. Tag & Nail NE side 12" Oak S 50° E 42.20' (m. 42.23')
K.C. Remon. Tag & Nail E side 12" Oak S 00° E 20.38' (m. 20.38')
K.C. Remon. Tag & Nail S side 14" Oak S 85° W 19.72'
Iron S 1.67' (m. 1.66')

The selected location is accepted by me and is generally accepted by professional surveyors as the best available evidence of the position of the original corner.

C. Description of monument for corner and accessories established to perpetuate locating the position of the corner:

G-1 Standard Kent County Monument

Nail & K.C. remon. tag on S side 14" Oak S 90° E 31.51'
Nail & K.C. remon. tag on NE side 12" Oak S 50° E 42.23'
Nail & K.C. remon. tag on E side 12" Oak S 00° E 20.38'
Nail & K.C. remon. tag on S side 14" Oak S 85° W 19.72'
Nail & K.C. remon. tag on W side 14" Cherry S 35° W 10.62'
K.C. Mon. G-13, T10N, R9W, East 152.04'

Signed by [Signature] Date _____
WILLIAMS & WORKS

Surveyor's Michigan License No. 25854

