

MAY 22 2000

\$7.00
\$2.00

SECTION LAND CORNER RECORDATION CERTIFICATE
Filing Requirement of Act 74, Mich. P.A. 1970
KENT COUNTY REMONUMENTATION

For corners in

Kent (County)	Located in: Oakfield Township	Corner Code #
1. Public Land Survey	T <u>9N</u> R <u>9W</u>	<u>G-3</u>
	T _____ R _____	_____
	T _____ R _____	_____
	T _____ R _____	_____
2. Property Controlling in Section	S _____ T _____ R _____	_____
	S _____ T _____ R _____	_____
3. Miscellaneous Property in Sec.	S _____ T _____ R _____	_____
	S _____ T _____ R _____	_____

REG. OF DEEDS


[Signature]

STATE OF MICHIGAN
COUNTY OF KENT
RECEIVED FOR RECORD
1999 DEC - 8 AM 10: 06

11551

Register of Deeds Stamp & File Number

- 4. Lot No. _____, Recorded Plat _____
- 5. Private Claims _____

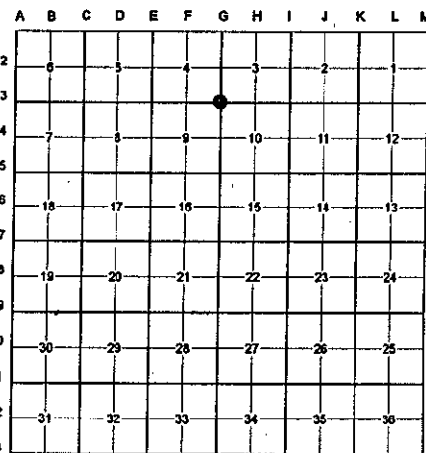

I, Randy Kolehouse, in a field survey on October 13 19 99, do hereby certify that under requirements of P.A. 74 Michigan P.A. of 1970, the corner points mentioned in lines 1 and 2 above were in conformance with regulations and rules therefore as required in the current manual of survey instructions of the United States Department of the Interior, Bureau of Land Management or by a decree of a Court of Law and/or that the corner points mentioned in lines 3, 4 and 5 above were in conformance with the rules of the Michigan Board of Land Surveyors or by a Decree of a Court of Law; established, re-established, monumented, re-monumented, recovered, found as expressed below:

NOTE: Not more than 4 corners, all in the same town and range, may be recorded on this certificate.

A. Description of original monument and accessories and/or subsequent restoration:

G-3	1837	G.L.O. Notes	Cathcart	Set Post	P.A. 345 1990 KENT COUNTY
	1894	Records	Williams & Works	Set Stake & Stone	PEER APPROVED <u>10/29/99</u>
	N/A	Witness Map	K.C. Surveyor	Stake	CHAIRMAN <u>Randy Kolehouse</u>
	1985	Records	All Points	"T" Fence Post	
	1992	L.C.R.C. #6587	John Bueche	Fnd. "T" Fence Post / Set K.C. Monument	
	1997	L.C.R.C. #9679	Kirk Breitels	K.C. Monument	

This corner was originally approved by the Kent County Remonumentation Peer Group and monumented by John Bueche in August of 1992 and was recorded per L.C.R.C. #6587.

B. Description of corner evidence found and/or method applied in restoring or reestablishing corner:

G-3 The K.C. Monument at this corner has been destroyed. Set a point on the C/L of Heintzleman Avenue (bit.) running North and South using one witness (house corner) and 33.00 feet East of "T" iron to the West and 33.00 feet West of Roosien iron to the East.

L.C.R.C. #6587

L.C.R.C. #9679

SW cor. garg. fnd. to hse. #12429 N 50° W 114.71'


SW cor. gar. siding trim to hse. #12429 N50°W 114.28'

The selected location is accepted by me and is generally accepted by professional surveyors as the best available evidence of the position of the original corner.

C. Description of monument for corner and accessories established to perpetuate locating the position of the corner:

G-3 Reset a Standard Kent County Monument

- *Nail & K.C. remon. tag on SW side 30" Oak S 50° E 103.50'
- Nail & K.C. remon. tag on S side 24" Oak S 85° W 63.37'
- Nail & K.C. remon. tag on NW side 14" Oak N 35° E 80.70'
- SE cor. gar. Siding trim to Hse. #12429 N 50° W 114.28'
- "T" iron West 33.00'
- Roosien iron East 33.00'
- On C/L of bit. road running N-S

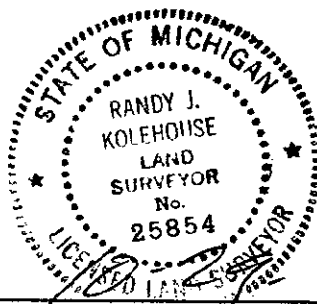

Signed by Randy J. Kolehouse Date _____

WILLIAMS & WORKS

Surveyor's Michigan License No. 25854