

SURVEY &
REMONUMENTATION

MAY 22 2000

LAND CORNER RECORDATION CERTIFICATE
Filing Requirement of Act 74, Mich. P.A. 1970
KENT COUNTY REMONUMENTATION

STATE OF MICHIGAN
COUNTY OF KENT
RECEIVED FOR RECORD
1999 DEC - 8 AM 10:06

\$7.00
\$2.00

For corners in

SECTION

Kent (County)	Located in: Oakfield Township	Corner Code #
1. Public Land Survey	T <u>9N</u> R <u>9W</u>	<u>G-5</u>
	T _____ R _____	_____
	T _____ R _____	_____
	T _____ R _____	_____
2. Property Controlling in Section	S _____ T _____ R _____	_____
	S _____ T _____ R _____	_____
3. Miscellaneous Property in Sec.	S _____ T _____ R _____	_____
	S _____ T _____ R _____	_____

REG. OF DEEDS

[Signature]


11553

Register of Deeds Stamp & File Number

4. Lot No. _____, Recorded Plat _____
5. Private Claims _____

I, Randy Kolehouse, in a field survey on October 14 19 99, do hereby certify that under requirements of P.A. 74 Michigan P.A. of 1970, the corner points mentioned in lines 1 and 2 above were in conformance with regulations and rules therefore as required in the current manual of survey instructions of the United States Department of the interior, Bureau of Land Management or by a decree of a Court of Law and/or that the corner points mentioned in lines 3, 4 and 5 above were in conformance with the rules of the Michigan Board of Land Surveyors or by a Decree of a Court of Law; established, re-established, monumented, re-monumented, recovered, found as expressed below:

NOTE: Not more than 4 corners, all in the same town and range, may be recorded on this certificate.

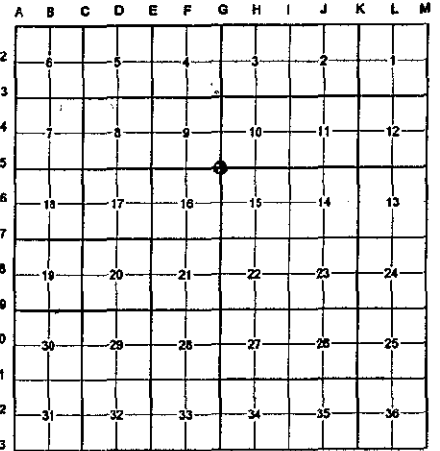

A. Description of original monument and accessories and/or subsequent restoration:

G-5	1837	G.L.O. Notes	Cathcart	Set Post
	1932-63	Witness Map	K.C. Surveyor	1" Iron in Mon. Box
	1971	L.C.R.C. #78	M.M. Chambers	1/2" Solid Iron in Mon. Box
	1981	L.C.R.C. #1668	Williams & Works	Fnd. 1/2" Solid Iron / Set K.C. Monument in Mon. Box
	1989	L.C.R.C. #5209	John Bueche	K.C. Monument in Mon. Box
	1997	L.C.R.C. #9681	Kirk Breitels	K.C. Monument

P.A. 345 1990 KENT COUNTY

PEER APPROVED 10/28/99

CHAIRMAN [Signature]

This corner was originally approved by the Kent County Remonumentation Peer Group and monumented by Williams & Works on 4/15/81 and was recorded per L.C.R.C. #1668.

B. Description of corner evidence found and/or method applied in restoring or reestablishing corner:

G-5 Found a Standard Kent County Monument 1' ± South of the C/L intersection of 14 Mile Road (bit.) running East and West and Heintzelmann Avenue (bit.) running North and (gravel) South per L.C.R.C.'s #1668, #5209 and #9681 as set by Williams & Works in place of a 1/2" solid iron he found which checked L.C.R.C. #78 and the K.C. Surveyor's records.

L.C.R.C. #1668

L.C.R.C. #9681

K.C. Remon. tag and nail in E side Power Pole S40°W 114.81'
K.C. Remon. tag and nail in E side Power Pole N55°E. 96.63'
Center line X 14 Mile Rd. (asphalt) E & W and Heintzelman
(gravel) N & S, nails E 2.99' and S 2.99'


Nail & KC Remon. tag E. side P. pole S40°W 114.82' (m. 114.87')
Nail & KC Remon. tag E. side P. pole N55°E 96.86' (m. 96.79')
Nail & KC Remon. tag NE side new P. Pole S25°E 130.68' (m. 130.60')
Near C/L "X" 14 Mile Rd. (blacktop) E-W & Heintzelman (gravel)

The selected location is accepted by me and is generally accepted by professional surveyors as the best available evidence of the position of the original corner.

C. Description of monument for corner and accessories established to perpetuate locating the position of the corner:

G-5 Standard Kent County Monument

Nail & K.C. remon. tag on W side P. pole N 10° W 223.20'
Nail & K.C. remon. tag on E side P. pole S 40° W 114.87'
Nail & K.C. remon. tag on NE side P. pole S 25° E 130.60'
Nail & K.C. remon. tag on E side P. pole N 55° E 96.79'
C/L of bit. road running E-W, North 1' ±
On C/L of bit. road running N and gravel road running S

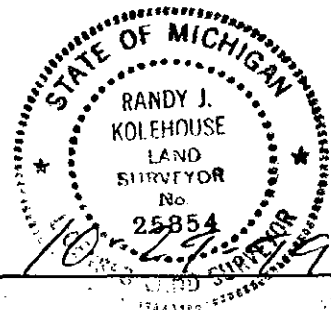

Signed by *[Signature]* Date _____
WILLIAMS & WORKS

Surveyor's Michigan License No. 25854