

SURVEY & REMONUMENTATION

MAY 22 2000

LAND CORNER RECORDATION CERTIFICATE
Filing Requirement of Act 74, Mich. P.A. 1970
KENT COUNTY REMONUMENTATION

For corners in


SECTION

Table with columns: Kent (County), Located in: Oakfield Township, Corner Code #. Rows include Public Land Survey, Property Controlling in Section, Miscellaneous Property in Sec., Lot No., and Private Claims.

REG. OF DEEDS stamp with handwritten signature and date 1999 OCT 27 AM 8:38. Includes stamp number 11434 and Register of Deeds Stamp & File Number.

I, Randy Kolehouse, in a field survey on March 16, 1999, do hereby certify that under requirements of P.A. 74 Michigan P.A. of 1970, the corner points mentioned in lines 1 and 2 above were in conformance with regulations and rules therefore as required in the current manual of survey instructions of the United States Department of the Interior, Bureau of Land Management or by a decree of a Court of Law and/or that the corner points mentioned in lines 3, 4 and 5 above were in conformance with the rules of the Michigan Board of Land Surveyors or by a Decree of a Court of Law, established, re-established, monumented, re-monumented, recovered, found as expressed below:

NOTE: Not more than 4 corners, all in the same town and range, may be recorded on this certificate.

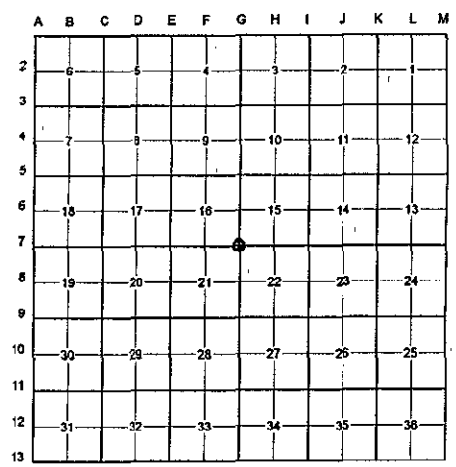

A. Description of original monument and accessories and/or subsequent restoration:

Table with 4 columns: G-7, 1837, G.L.O. Notes, Cathcart, Set Post. Rows list various survey notes and monument types like 1" Pipe, 1" Iron, and K.C. Monument.

This corner was originally approved by the Kent County Remonumentation Peer Group and monumented by Rob Jonker on 6/2/81 and was recorded per L.C.R.C. #1871.

B. Description of corner evidence found and/or method applied in restoring or reestablishing corner:

G-7 Found a Standard Kent County Monument 1' North of the C/L of 13 Mile Road (gravel) running East and West and 9' East of the C/L of Heintzelman Avenue (gravel) running North, on line of a fence line running South, per L.C.R.C.'s #1871, #5211, and #9683 as set by Rob Jonker in place of a 1" iron he found over a 4' plat monument 15" below grade which checked L.C.R.C. #1261 and the K.C. Surveyor's records.

L.C.R.C. #1871

L.C.R.C. #9683

Remon. tag on SE side 36" oak N50°E 37.3
Remon. tag on E side 36" oak S0°E 30.56
Remon. tag on S side 12" popl. N80°W 86.36
Remon. tag on W side p. pole N35°W 85.6
Centerline "X" of gravel is 9'W & 1'S

Nail & KC Remon. tag SE side 44" Oak N50°E 37.36' (m. 37.37')
Nail & KC Remon. tag E. side 44" Oak S00°E 30.56' (m. 30.47')
Nail & KC Remon. tag S. side 24" Poplar N80°W 86.26' (m. 86.21')
Nail & KC Remon. tag W. side P. Pole N35°W 85.65' (m. 85.63')
Nail & KCK Remn. Tag S. side 28" Oak N75°E 71.15' (m. 71.18')
Centerline "X" of gravel is 9' W. & 1' S.


The selected location is accepted by me and is generally accepted by professional surveyors as the best available evidence of the position of the original corner.

C. Description of monument for corner and accessories established to perpetuate locating the position of the corner:

G-7 Standard Kent County Monument

Nail & K.C. remon. tag on SE side 44" Oak N 50° E 37.37'
Nail & K.C. remon. tag on E side 44" Oak S 00° E 30.47'
Nail & K.C. remon. tag on W side P. pole N 35° W 85.63'
Nail & K.C. remon. tag on S side 28" Oak N 75° E 71.18'
Nail & K.C. remon. tag on S side 26" Poplar N 35° W 86.21'
C/L of gravel road running E-W, South 1' ±
C/L of gravel road running N-S, West 9' ±
On fence line running S

P.A. 345 1990 KENT COUNTY PEER APPROVED 7/29/99 CHAIRMAN Randy Kolehouse

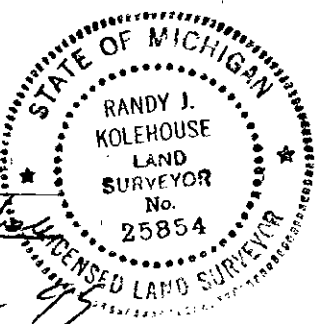

Signed by Randy J. Kolehouse Date 10-11-99

Surveyor's Michigan License No. 25854