

SURVEY &
REMONUMENTATION

MAY 22 2000

LAND CORNER RECORDATION CERTIFICATE
Filing Requirement of Act 74, Mich. P.A. 1970
KENT COUNTY REMONUMENTATION

For corners in SECTION
Kent
(County)

Located in:	Oakfield Township	Corner Code #
1. Public Land Survey	T <u>9N</u> R <u>9W</u>	<u>G-9</u>
	T _____ R _____	_____
	T _____ R _____	_____
	T _____ R _____	_____
2. Property Controlling in Section	S _____ T _____ R _____	_____
	S _____ T _____ R _____	_____
3. Miscellaneous Property in Sec.	S _____ T _____ R _____	_____
	S _____ T _____ R _____	_____

REG. OF DEEDS

STATE OF MICHIGAN
COUNTY OF KENT
RECEIVED FOR RECORD
1999 OCT 27 AM 8:38

11436

Register of Deeds Stamp & File Number

4. Lot No. _____ Recorded Plat _____
5. Private Claims _____

I, Randy Kolehouse, in a field survey on March 17 19 99, do hereby certify that under requirements of P.A. 74 Michigan P.A. of 1970, the corner points mentioned in lines 1 and 2 above were in conformance with regulations and rules therefore as required in the current manual of survey instructions of the United States Department of the Interior, Bureau of Land Management or by a decree of a Court of Law and/or that the corner points mentioned in lines 3, 4 and 5 above were in conformance with the rules of the Michigan Board of Land Surveyors or by a Decree of a Court of Law; established, re-established, monumented, re-monumented, recovered, found as expressed below:

NOTE: Not more than 4 corners, all in the same town and range, may be recorded on this certificate.

A. Description of original monument and accessories and/or subsequent restoration:

G-9	1837	G.L.O. Notes	Cathcart	Set Post
	1983	L.C.R.C. #3571	William Byl	Fnd. Remains of Post / Set K.C. Monument
	1989	L.C.R.C. #5213	John Bueche	K.C. Monument
	1997	L.C.R.C. #9685	Kirk Breitels	K.C. Monument

P.A. 345 1990 KENT COUNTY
PEER APPROVED 7/29/99
CHAIRMAN [Signature]

This corner was originally approved by the Kent County Remonumentation Peer Group and monumented by William Byl on 9/1/81 and was recorded per L.C.R.C. #3571.

B. Description of corner evidence found and/or method applied in restoring or reestablishing corner:

G-9 Found a Standard Kent County Monument in a swamp 100' ± South of the C/L of creek and 250' ± North of South edge of swamp per L.C.R.C.'s #3571, #5213, and #9685 as set by William Byl in place of the remains of a post he found 12" below ground which checked Cathcart's 1837 G.L.O. notes.

L.C.R.C. #3571

L.C.R.C. #9685

Nail & tag, E sd. 10" Cedar N 35 E 17.12'
Nail & tag, E sd. 16" Cedar N 15 W 42.48'
Nail & tag, E sd. 16" Cedar N 45 W 22.64'
Nail & tag, N sd. 16" Tamarack M 85 W 21.33'


Nail & KC Remon. tag E. side 12" Cedar N35°E 17.12'
Nail & KC Remon. tag E. side 18" Cedar N15°E 42.48' (m. 42.44')
Nail & KC Remon. tag E. side 16" Cedar N45°W 22.61' (m. 22.60')
Nail & KC Remon. tag N. side 16" Tamarak N85°W 21.33'
Creek North 100'+/-

The selected location is accepted by me and is generally accepted by professional surveyors as the best available evidence of the position of the original corner.

C. Description of monument for corner and accessories established to perpetuate locating the position of the corner:

G-9 Standard Kent County Monument

Nail & K.C. remon. tag on E side 12" Cedar N 35° E 17.12'
Nail & K.C. remon. tag on E side 18" Cedar N 15° E 42.44'
Nail & K.C. remon. tag on E side 16" Cedar N 45° W 22.60'
Nail & K.C. remon. tag on N side 16" Tamarack N 85° W 21.33'
C/L creek North 100' +/-
S edge swamp South 250' +/-

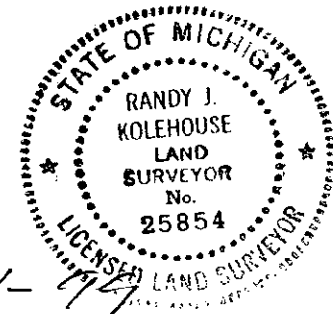

Signed by [Signature] Date 10-11-99

WILLIAMS & WORKS

Surveyor's Michigan License No. 25854