

MAR 08 1999

\$7.00  
\$2.00

SECTION

LAND CORNER RECORDATION CERTIFICATE  
Filing Requirement of Act 74, Mich. P.A. 1970  
KENT COUNTY REMONUMENTATION

STATE OF MICHIGAN  
COUNTY OF KENT  
RECEIVED FOR RECORD  
38 DEC 14 AM 8:00  
REG. OF DEEDS  
*Dave Bond*

For corners in


Kent (County)	Located in:	Oakfield Township	Corner Code #
1. Public Land Survey	T <u>9N</u>	R <u>9W</u>	<u>G-13</u>
	T _____	R _____	_____
	T _____	R _____	_____
	T _____	R _____	_____
2. Property Controlling in Section	S _____	T _____	R _____
	S _____	T _____	R _____
3. Miscellaneous Property in Sec.	S _____	T _____	R _____
	S _____	T _____	R _____

11015

Register of Deeds Stamp & File Number

4. Lot No. \_\_\_\_\_, Recorded Plat \_\_\_\_\_  
5. Private Claims \_\_\_\_\_

I, Randy Kolehouse, in a field survey on December 4 19 98, do hereby certify that under requirements of P.A. 74 Michigan P.A. of 1970, the corner points mentioned in lines 1 and 2 above were in conformance with regulations and rules therefore as required in the current manual of survey instructions of the United States Department of the interior, Bureau of Land Management or by a decree of a Court of Law and/or that the corner points mentioned in lines 3, 4 and 5 above were in conformance with the rules of the Michigan Board of Land Surveyors or by a Decree of a Court of Law; established, re-established, monumented, re-monumented, recovered, found as expressed below:

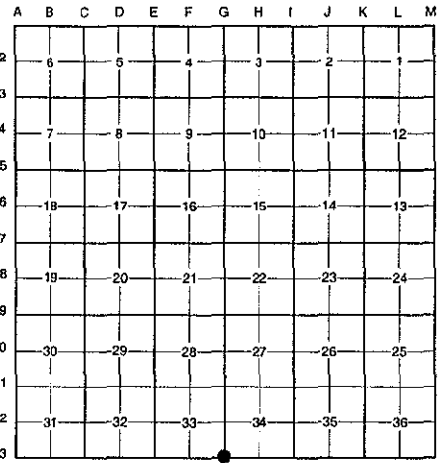

NOTE: Not more than 4 corners, all in the same town and range, may be recorded on this certificate.

A. Description of original monument and accessories and/or subsequent restoration:

G-13	1837	G.L.O. Notes	N. Brookfield	Set Post
	1972	L.C.R.C. #363	Exxel Engineering	3/4" Iron
	1973	L.C.R.C. #369	Exxel Engineering	3/4" Iron
	1981	L.C.R.C. #1676	Williams & Works	Fnd. 3/4" Iron / Set K.C. Monument in ring of Stones
	1989	L.C.R.C. #5215	John Bueche	Reset K.C. Monument
	1997	L.C.R.C. #9692	Kirk Breitels	K.C. Monument

Note: This corner is not common with G-1, T8N, R9W.

This corner was originally approved by the Kent County Remonumentation Peer Group and monumented by Williams & Works on 2/27/81 and was recorded per L.C.R.C. #1676.

P.A. 345 1990 KENT COUNTY  
PEER APPROVED 9/24/98  
CHAIRMAN Randy Kolehouse

B. Description of corner evidence found and/or method applied in restoring or reestablishing corner:

G-13 Found a Standard Kent County Monument on line of a tree row running North and East and occupation line running West per L.C.R.C.'s #1676, #5215 and #9692 as set by Williams & Works in place of a 3/4" iron they found which checked L.C.R.C.'s #369 and #363.

L.C.R.C. #1676

Nail & K.C. Remon. Tag in W. Side 12" B. Elder N 104.0'  
Nail & K.C. Remon. Tag in N. Side 6" Mulberry E 70.22'  
Nail & K.C. Remon. Tag in SE Side 20" Quad B. Elder S 75°W 215.26'

L.C.R.C. #9692

Nail & KC Remon. tag W. side 20" B. Elder North 104.06' (m. 104.04')  
Nail & KC Remon. tag N. side clust. 8"-16" Mulberry East 70.26' (m. 70.27')  
Nail & KC Remon. tag SE side 24" Quad B. Elder S70°W 214.46' (m. 214.42')  
Nail & KC Remon. tag N. side clust. 4"-8" Cherry N60°E 8.87' (m. 8.84')  
K.C. Mon. (G-1, T8N, R9W) N90°W 204.60' (m. 204.70')

The selected location is accepted by me and is generally accepted by professional surveyors as the best available evidence of the position of the original corner.

C. Description of monument for corner and accessories established to perpetuate locating the position of the corner:

G-13 Standard Kent County Monument

Nail & K.C. remon. tag on W side 20" Box Elder North 104.04'  
Nail & K.C. remon. tag on N side 8"-16" clust. Mulberry East 70.27'  
Nail & K.C. remon. tag on SE side 24" quad. Box Elder S 70° W 214.42'  
Nail & K.C. remon. tag on N side clust. 4"-8" Cherry N60°E 8.84'  
On tree row running N-E  
On occupation line running W  
K.C. Mon. G-1, T8N-R9W, N 90° W 204.70'



Signed by Randy J. Kolehouse  
EARTH TECH

Date 12/15/98

Surveyor's Michigan License No. 25854