

**SURVEY &  
REMONUMENTATION**

MAY 22 2000

\$7.00  
\$2.00

**LAND CORNER RECORDATION CERTIFICATE**  
Filing Requirement of Act 74, Mich. P.A. 1970  
KENT COUNTY REMONUMENTATION

SECTION \_\_\_\_\_

For corners in

Kent (County)	Located in:	Oakfield Township	Corner Code #
1. Public Land Survey	T <u>9N</u>	R <u>9W</u>	<u>H-1</u>
	T _____	R _____	_____
	T _____	R _____	_____
	T _____	R _____	_____
2. Property Controlling in Section	S _____	T _____	R _____
	S _____	T _____	R _____
3. Miscellaneous Property in Sec.	S _____	T _____	R _____
	S _____	T _____	R _____

REG. OF DEEDS

*[Signature]*

STATE OF MICHIGAN  
COUNTY OF KENT  
RECEIVED FOR RECORD  
1999 DEC - 8 AM 10:06

**11559**

Register of Deeds Stamp & File Number

4. Lot No. \_\_\_\_\_, Recorded Plat \_\_\_\_\_  
5. Private Claims \_\_\_\_\_

	A	B	C	D	E	F	G	H	I	J	K	L	M
2													
3													
I, Randy Kolehouse, in a field survey on March 16 19 99, do hereby certify that under requirements of P.A. 74 Michigan P.A. of 1970, the corner points mentioned in lines 1 and 2 above were in conformance with regulations and rules therefore as required in the current manual of survey instructions of the United States Department of the Interior, Bureau of Land Management or by a decree of a Court of Law and/or that the corner points mentioned in lines 3, 4 and 5 above were in conformance with the rules of the Michigan Board of Land Surveyors or by a Decree of a Court of Law; established, re-established, monumented, re-monumented, recovered, found as expressed below:

**NOTE: Not more than 4 corners, all in the same town and range, may be recorded on this certificate.**

A. Description of original monument and accessories and/or subsequent restoration:

H-1 This corner was not originally set by the G.L.O.

1984	L.C.R.C. #4003	John Bueche	Set K.C. Monument in Swamp
1989	L.C.R.C. #5071	John Bueche	K.C. Monument in Swamp
1997	L.C.R.C. #9982	Kirk Breitels	K.C. Monument in Swamp

P.A. 345 1990 KENT COUNTY  
PEER APPROVED 10/28/99  
CHAIRMAN [Signature]

Note: This corner is not common with H-13, T10N, R9W.

This corner was originally approved by the Kent County Remonumentation Peer Group and monumented by John Bueche on 10/17/84 and was recorded per L.C.R.C. #4003.

B. Description of corner evidence found and/or method applied in restoring or reestablishing corner:

H-1 Found a Standard Kent County Monument in a swamp (water 2' ± deep) 150' ± West of the C/L of Podunk Road (gravel) running North and South per L.C.R.C.'s #4003, #5071, and #9982 as set by John Bueche on the South line of Section 34 using government notes.

L.C.R.C. #4003

L.C.R.C. #9982

K.C. Remon. tag & nail in N. side 20" Willow N 85° W 40.03'  
K.C. Remon. tag & nail in N. side 10" Elm N 80° E 11.70'  
K.C. Remon. tag & nail in E. side 6" Maple N 30° E 17.90'  
K.C. Remon. tag & nail in N. side 4" maple N 60° E 28.35'  
K.C. Remon. tag & nail in W. side 10" Maple N 30° W 26.46'


Nail & KC Remon. tag N. side 12" stump N80°E 11.70'  
Nail & KC Remon. tag E. side 8" stump N30°E 17.90'  
Nail & KC Remon. tag S. side 4" Maple N85°W 36.54'  
Nail & KC Remon. tag W. side 8" Elm S05°W 19.97'  
KC Mon. (H-13, 10-9) East 120.45'

The selected location is accepted by me and is generally accepted by professional surveyors as the best available evidence of the position of the original corner.

C. Description of monument for corner and accessories established to perpetuate locating the position of the corner:

H-1 Standard Kent County Monument

\*Nail & K.C. remon. tag on N side 12" stump N 80° E 11.70'  
Nail & K.C. remon. tag on E side 8" stump N 30° E 17.90'  
Nail & K.C. remon. tag on S side 4" stump N 85° W 36.54'  
Nail & K.C. remon. tag on W side 8" Elm S 05° W 19.97'  
C/L of gravel road running N-S, East 150' ±  
K.C. Mon., H-13, T10N, R9W, East 120.45'

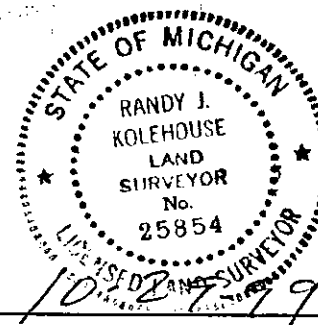

Signed by Randy J. Kolehouse Date 10/28/99

WILLIAMS & WORKS

Surveyor's Michigan License No. 25854