

MAY 22 2000

\$7.00
\$2.00

SECTION

LAND CORNER RECORDATION CERTIFICATE
Filing Requirement of Act 74, Mich. P.A. 1970
KENT COUNTY REMONUMENTATION

For corners in

Kent (County)	Located in: Oakfield Township	Corner Code #
1. Public Land Survey	T <u>9N</u> R <u>9W</u>	<u>H-2</u>
	T _____ R _____	_____
	T _____ R _____	_____
	T _____ R _____	_____
2. Property Controlling in Section	S _____ T _____ R _____	_____
	S _____ T _____ R _____	_____
3. Miscellaneous Property in Sec.	S _____ T _____ R _____	_____
	S _____ T _____ R _____	_____

REC. OF DEEDS
1999 DEC 27 AM 8:19
STATE OF MICHIGAN
COUNTY OF KENT
RECEIVED FOR RECORD

11642

Register of Deeds Stamp & File Number


4. Lot No. _____, Recorded Plat _____
5. Private Claims _____

I, Randy Kolehouse, in a field survey on December 15 19 99, do hereby certify that under requirements of P.A. 74 Michigan P.A. of 1970, the corner points mentioned in lines 1 and 2 above were in conformance with regulations and rules therefore as required in the current manual of survey instructions of the United States Department of the interior, Bureau of Land Management or by a decree of a Court of Law and/or that the corner points mentioned in lines 3, 4 and 5 above were in conformance with the rules of the Michigan Board of Land Surveyors or by a Decree of a Court of Law; established, re-established, monumented, re-monumented, recovered, found as expressed below:

NOTE: Not more than 4 corners, all in the same town and range, may be recorded on this certificate.

A. Description of original monument and accessories and/or subsequent restoration:

H-2	This corner was not originally set by the G.L.O.	N/A	Witness Map	K.C. Surveyor	Iron
		1967	Survey Records	McMahon	N/A
		1978	Survey Records	Glaza	N/A

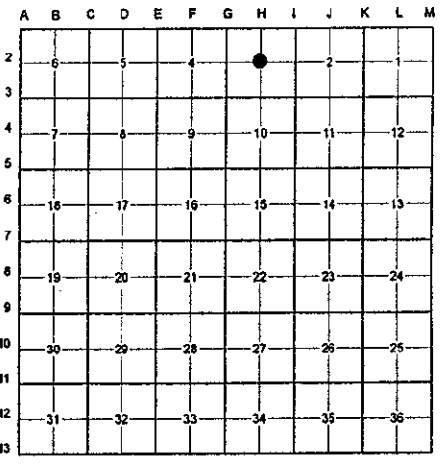

P.A. 345 1990 KENT COUNTY
PEER APPROVED 10/28/99
CHAIRMAN [Signature]

B. Description of corner evidence found and/or method applied in restoring or reestablishing corner:


H-2 Found a 1/2" iron pipe on the C/L of MacClain Street (bit.) running East and West and on the C/L of Podunk (gravel) running South and 65' West of the C/L of Podunk Avenue running North. The found 1/2" iron is 4.2' East and 3.5' North of the intersection of 1/4 lines and checks surveys by Glaza, Arnoch, and McMahon. Held 1/2" iron for Center of Section.

The selected location is accepted by me and is generally accepted by professional surveyors as the best available evidence of the position of the original corner.

C. Description of monument for corner and accessories established to perpetuate locating the position of the corner:

H-2 Replaced 1/2" Iron Pipe with a Standard Kent County Monument - Also Set a Monument Box

- Nail & K.C. remon. tag on W face 28" Walnut N 40° E 46.88'
- Nail & K.C. remon. tag on S face 32" Oak N 70° E 104.00'
- SE corner conc. block fndn. N 15° W 72.12'
- NW cor. garage fndn. S 50° E 123.78'
- On C/L of bit. road running E-W
- On C/L of gravel road running S
- C/L of gravel road running N, East 65'

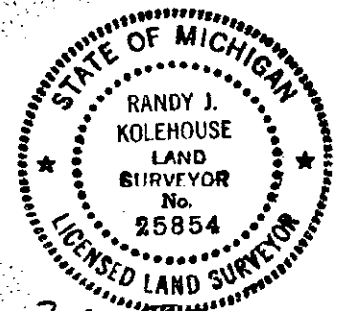

Signed by [Signature] Date 12-20-99
WILLIAMS & WORKS

Surveyor's Michigan License No. 25854