

\$7.00
\$2.00

MAY 22 2000

LAND CORNER RECORDATION CERTIFICATE
Filing Requirement of Act 74, Mich. P.A. 1970
KENT COUNTY REMONUMENTATION

For corners in

SECTION

Kent (County)	Located in: Oakfield Township	Corner Code #
1. Public Land Survey	T <u>9N</u> R <u>9W</u>	<u>H-3</u>
	T _____ R _____	_____
	T _____ R _____	_____
	T _____ R _____	_____
2. Property Controlling in Section	S _____ T _____ R _____	_____
	S _____ T _____ R _____	_____
3. Miscellaneous Property in Sec.	S _____ T _____ R _____	_____
	S _____ T _____ R _____	_____

REG. OF DEEDS


[Signature]

STATE OF MICHIGAN
COUNTY OF KENT
RECEIVED FOR RECORD
1999 DEC - 8 AM 10: 07

11560

Register of Deeds Stamp & File Number

- 4. Lot No. _____, Recorded Plat _____
- 5. Private Claims _____

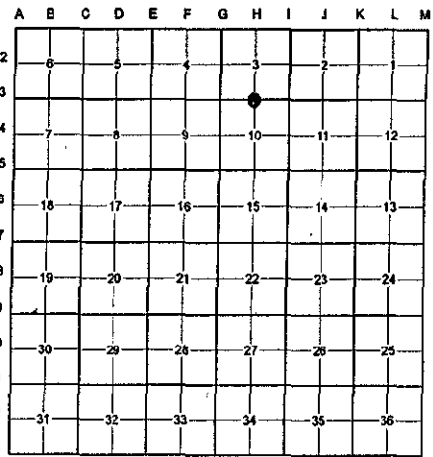

I, Randy Kolehouse, in a field survey on August 19 19 99, do hereby certify that under requirements of P.A. 74 Michigan P.A. of 1970, the corner points mentioned in lines 1 and 2 above were in conformance with regulations and rules therefore as required in the current manual of survey instructions of the United States Department of the Interior, Bureau of Land Management or by a decree of a Court of Law and/or that the corner points mentioned in lines 3, 4 and 5 above were in conformance with the rules of the Michigan Board of Land Surveyors or by a Decree of a Court of Law; established, re-established, monumented, re-monumented, recovered, found as expressed below:

NOTE: Not more than 4 corners, all in the same town and range, may be recorded on this certificate.

A. Description of original monument and accessories and/or subsequent restoration:

H-3	1837	G.L.O. Notes	Cathcart	Set Post
	1846-1906	Notes	Williams & Works	Government Stake
	N/A	Witness Map	K.C. Surveyor	RR Spike
	1984	Survey	Medema, Van Kooten & Associates	Set Iron
	1992	L.C.R.C. #6588	John Bueche	Fnd. Iron / Set K.C. Monument
	1994	L.C.R.C. #7207	Glaza & Associates	K.C. Monument

P.A. 345 1990 KENT COUNTY

PEER APPROVED 10/28/99

CHAIRMAN *[Signature]*

This corner was originally approved by the Kent County Remonumentation Peer Group and monumented by John Bueche in August 1992 and was recorded per L.C.R.C. #6588.

B. Description of corner evidence found and/or method applied in restoring or reestablishing corner:

H-3 Found a Standard Kent County Monument on the C/L of Podunk Avenue (gravel) running North and South per L.C.R.C.'s #6588 and #7207 as set by John Bueche in place of a MVK iron he found which checked a 1984 survey by Medema, Van Kooten & Associates, the K.C. Surveyor's records, and the notes of Williams & Works.

L.C.R.C. #6588

L.C.R.C. #7207

Nail & K.C. Remon. Tag E side 24" Oak S 5° W 161.58'
Nail & K.C. Remon. Tag W side 30" Willow S E 142.79'
Cut nail E side 18" Oak N 5° W 142.82'
Iron West 14.01' & East 33.02'
On C/L gravel N-S

Nail & K.C. remon tag in E side 24" Oak S05°W 161.55' (m. 161.48')
Nail & K.C. remon tag in W side 30" Willow S05°E 142.74' (m. 142.56')
Cut nail in E side 18" Oak N05°W 142.82' (m. 142.78')
Iron West 14.01' (m. 14.28')
Nail & K.C. remon tag in W side P. pole N11°E 160.83' (m. 160.75')
On C/L gravel N-S

The selected location is accepted by me and is generally accepted by professional surveyors as the best available evidence of the position of the original corner.

C. Description of monument for corner and accessories established to perpetuate locating the position of the corner:

H-3 Standard Kent County Monument

Nail & K.C. remon. tag on E side 20" Oak N 05° W 142.78'
Nail & K.C. remon. tag on W side 32" Willow S 05° E 142.56'
Nail & K.C. remon. tag on E side 26" Oak S 05° W 161.48'
Nail & K.C. remon. tag on W side P. pole N 11° E 160.75'
Nail & K.C. remon. tag on E side P. pole S 18° W 177.14'
Iron West 14.28'
On C/L of gravel road running N-S

Signed by *Randy J. Kolehouse* Date _____
WILLIAMS & WORKS

Surveyor's Michigan License No. 25854

