

MAY 22 2000

\$7.00
\$2.00

SECTION

LAND CORNER RECORDATION CERTIFICATE

Filing Requirement of Act 74, Mich. P.A. 1970

KENT COUNTY REMONUMENTATION

For corners in

Kent
(County)

Located in: Oakfield
Township

Corner Code #

- | | | | | | |
|------------------------------------|---|-----------|---|-----------|------------|
| 1. Public Land Survey | T | <u>9N</u> | R | <u>9W</u> | <u>H-4</u> |
| | T | | R | | |
| | T | | R | | |
| | T | | R | | |
| 2. Property Controlling in Section | S | | T | | R |
| | S | | T | | R |
| 3. Miscellaneous Property in Sec. | S | | T | | R |
| | S | | T | | R |

4. Lot No. _____, Recorded Plat _____
 5. Private Claims _____

I, Randy Kolehouse, in a field survey on December 14 19 99, do hereby certify that under requirements of P.A. 74 Michigan P.A. of 1970, the corner points mentioned in lines 1 and 2 above were in conformance with regulations and rules therefore as required in the current manual of survey instructions of the United States Department of the interior, Bureau of Land Management or by a decree of a Court of Law and/or that the corner points mentioned in lines 3, 4 and 5 above were in conformance with the rules of the Michigan Board of Land Surveyors or by a Decree of a Court of Law; established, re-established, monumented, re-monumented, recovered, found as expressed below:

NOTE: Not more than 4 corners, all in the same town and range, may be recorded on this certificate.

A. Description of original monument and accessories and/or subsequent restoration:

H-4 This corner was not originally set by the G.L.O.

1939-63	Witness Map	K.C. Surveyor	1" Iron
1963	Records	M.D.S.H.	Iron
1981	L.C.R.C. #2317	Nederveld and Jonker	1/2" Iron
1985	Survey Records	All Points	iron

B. Description of corner evidence found and/or method applied in restoring or reestablishing corner:

H-4 Found three irons at this corner: (1) 1/2" iron pipe per Hackbart 1991 Survey which checks two remaining M.D.S.H. 1963 witnesses; (2) 1/2" rebar set by Nederveld & Associates using "record information" (Witnesses) which checks 1 witness from M.D.S.H. 1963 and is 1.4' Northwest of iron #1; (3) 3/4" iron (no record information) which checks no remaining witnesses and is 1.7' Northeast of iron #1. Iron #1 is 25.3' West and 0.1' North of intersection of 1/4 lines and is being used by M.D.S.H., Williams & Works and Hackbart and is on the approximate C/L intersection for roads running North-South and West because iron #1 checks 2 remaining 1963 witnesses and is being used by 3 firms held as the Center of Section.


The selected location is accepted by me and is generally accepted by professional surveyors as the best available evidence of the position of the original corner.

C. Description of monument for corner and accessories established to perpetuate locating the position of the corner:

H-4 Replaced 1/2" Iron with a Standard Kent County Monument

- Nail & K.C. remon. tag on W side P. pole N 30° E 65.46'
- Nail & K.C. remon. tag on N side 30" Oak S 70° E 76.34'
- Nail & K.C. remon. tag on SSW side 12" Pine S 35° E 55.27'
- Nail & K.C. remon. tag on NW side 20" Oak S 40° W 65.58'
- Nail & K.C. remon tag on N side P. pole S 70° W 209.33'
- C/L 13" Tamarack stump N 50° W 72.48'


P.A. 345 1990 KENT COUNTY
 PEER APPROVED 12/20/99
 CHAIRMAN Randy Kolehouse

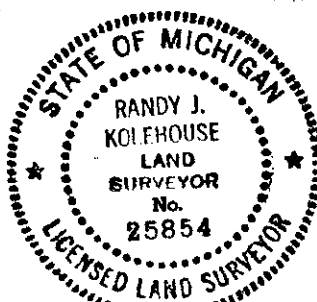

Signed by Randy J. Kolehouse Date 12-20-99

WILLIAMS & WORKS

Surveyor's Michigan License No. 25854

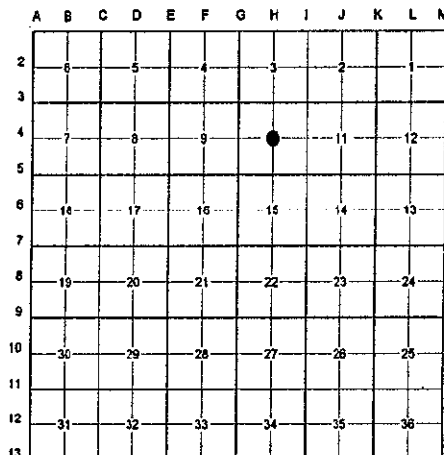

STATE OF MICHIGAN
 COUNTY OF KENT
 RECEIVED FOR RECORD
 1999 DEC 27 AM 8:19
 REG. OF DEEDS
 11643
 Register of Deeds Stamp & File Number