

MAY 22 2000

\$7.00  
\$2.00

SECTION

LAND CORNER RECORDATION CERTIFICATE  
Filing Requirement of Act 74, Mich. P.A. 1970  
KENT COUNTY REMONUMENTATION

For corners in

Kent (County)	Located in:	Oakfield Township	Corner Code #
1. Public Land Survey	T <u>9N</u>	R <u>9W</u>	<u>H-5</u>
	T _____	R _____	_____
	T _____	R _____	_____
	T _____	R _____	_____
2. Property Controlling in Section	S _____	T _____	R _____
	S _____	T _____	R _____
3. Miscellaneous Property in Sec.	S _____	T _____	R _____
	S _____	T _____	R _____

REG. OF DEEDS

*[Handwritten Signature]*

STATE OF MICHIGAN  
COUNTY OF KENT  
RECEIVED FOR RECORD  
1999 DEC - 8 AM 10:07


11561

Register of Deeds Stamp & File Number

4. Lot No. \_\_\_\_\_, Recorded Plat \_\_\_\_\_  
5. Private Claims \_\_\_\_\_

I, Randy Kolehouse, in a field survey on September 7 19 99, do hereby certify that under requirements of P.A. 74 Michigan P.A. of 1970, the corner points mentioned in lines 1 and 2 above were in conformance with regulations and rules therefore as required in the current manual of survey instructions of the United States Department of the interior, Bureau of Land Management or by a decree of a Court of Law and/or that the corner points mentioned in lines 3, 4 and 5 above were in conformance with the rules of the Michigan Board of Land Surveyors or by a Decree of a Court of Law; established, re-established, monumented, re-monumented, recovered, found as expressed below:

NOTE: Not more than 4 corners, all in the same town and range, may be recorded on this certificate.

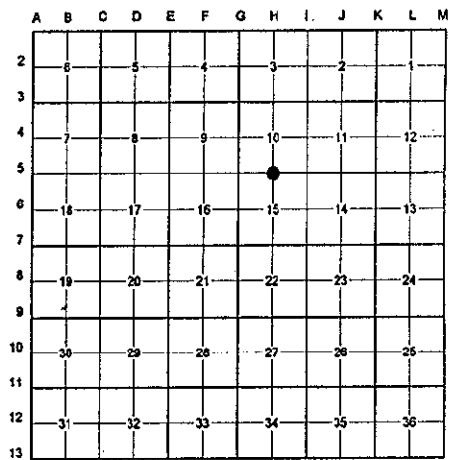

A. Description of original monument and accessories and/or subsequent restoration:

H-5	1837	G.L.O. Notes	Cathcart	Set Post	P.A. 345 1990 KENT COUNTY
	1941-63	Witness Map	K.C. Surveyor	Iron in Mon. Box	PEER APPROVED <i>10/28/99</i>
	1971	L.C.R.C. #78	M.M. Chambers	Iron in Mon. Box	CHAIRMAN <i>[Signature]</i>
	1981	L.C.R.C. #1675	Williams & Works	Fnd. 1/2" Solid Iron / Set K.C. Monument in Mon. Box	
	1994	L.C.R.C. #7209	Glaza & Associates	K.C. Monument	

This corner was originally approved by the Kent County Remonumentation Peer Group and monumented by Williams & Works on 4/15/81 and was recorded per L.C.R.C. #1675.

B. Description of corner evidence found and/or method applied in restoring or reestablishing corner:

H-5 Found a Standard Kent County Monument at the C/L intersection of 14 Mile Road (bit.) running East and West and Podunk Avenue (gravel) running North and (bit.) running South per L.C.R.C.'s #1675 and #7209 as set by Williams & Works in place of a 1/2" solid iron they found which checked L.C.R.C. #78 and the K.C. Surveyor's records.

L.C.R.C. #1675

K.C. Remon. tag and nail E side 12" Maple N.25°E. 142.65'  
K.C. Remon. tag and nail E side Power Pole S.10°E. 126.00'  
SW cor. conc. to MBT box N.45°E. 61.80'  
SE cor. hse. #12375 (fnd.) N.40°W. 154.12'


L.C.R.C. #7209

K.C. remon tag & nail in East side 16" Maple N31°E 142.61' (m. 142.66')  
K.C. remon tag & nail in East side P. pole S10°E 125.97' (m. 126.06')  
SW corner concrete to MBT box N52°E 61.81'  
SE corner of house #12375 (foundation) N31°W 153.99' (m. 154.05')

The selected location is accepted by me and is generally accepted by professional surveyors as the best available evidence of the position of the original corner.

C. Description of monument for corner and accessories established to perpetuate locating the position of the corner:

H-5 Standard Kent County Monument  
Nail & K.C. remon. tag on E face 16" Maple N 31° E 142.66'  
Nail & K.C. remon. tag on E face P. pole S 10° E 126.06'  
SW cor. conc. to MBT box N 52° E 61.81'  
SE cor. hse. fndn. #12375 N 31° W 154.05'  
On C/L of bit. road running E-W  
On C/L of gravel road running N and bit. road running S

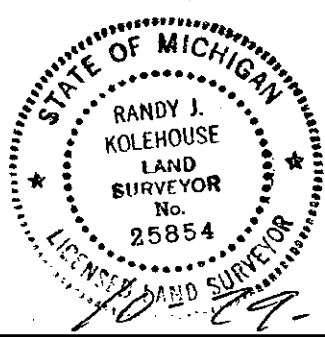

Signed by *Randy J. Kolehouse* Date 10-29-99  
WILLIAMS & WORKS

Surveyor's Michigan License No. 25854