

MAY 22 2000

\$7.00
\$2.00

SECTION

LAND CORNER RECORDATION CERTIFICATE
Filing Requirement of Act 74, Mich. P.A. 1970
KENT COUNTY REMONUMENTATION

For corners in

Kent
(County)

Located in: Oakfield
Township

Corner Code #

- | | | | | | |
|------------------------------------|---|-----------|---|-----------|------------|
| 1. Public Land Survey | T | <u>9N</u> | R | <u>9W</u> | <u>H-8</u> |
| | T | | R | | |
| | T | | R | | |
| | T | | R | | |
| 2. Property Controlling in Section | S | | T | | |
| | S | | T | | |
| 3. Miscellaneous Property in Sec. | S | | T | | |
| | S | | T | | |

4. Lot No. _____, Recorded Plat _____
5. Private Claims _____

I, Randy Kolehouse, in a field survey on December 16 19 99, do hereby certify that under requirements of P.A. 74 Michigan P.A. of 1970, the corner points mentioned in lines 1 and 2 above were in conformance with regulations and rules therefore as required in the current manual of survey instructions of the United States Department of the Interior, Bureau of Land Management or by a decree of a Court of Law and/or that the corner points mentioned in lines 3, 4 and 5 above were in conformance with the rules of the Michigan Board of Land Surveyors or by a Decree of a Court of Law; established, re-established, monumented, re-monumented, recovered, found as expressed below:

NOTE: Not more than 4 corners, all in the same town and range, may be recorded on this certificate.

A. Description of original monument and accessories and/or subsequent restoration:

H-8 This corner was not originally set by the G.L.O.
No corner on record

1979 Survey Records Williams & Works Held intersection of 1/4 lines

B. Description of corner evidence found and/or method applied in restoring or reestablishing corner:

H-8 This corner falls in a large swamp on the Southwesterly side of Little Wabasis Lake and has never been set. Calculated the intersection of 1/4 lines and set reference monuments West and South of H-8 on the East-West and North-South 1/4 lines.

The selected location is accepted by me and is generally accepted by professional surveyors as the best available evidence of the position of the original corner.

C. Description of monument for corner and accessories established to perpetuate locating the position of the corner:


H-8 Set a Kent County Reference Monument South 1594.79' of H-8
Nail & K.C. remon. tag on S side 12" Oak N 85° W 10.72'
Nail & K.C. remon. tag on W side 10" triple Oak N 25° W 17.22'
Nail & K.C. remon. tag on NW side 18" Pine N 35° E 56.56'
Nail & K.C. remon. tag on W side 30" Oak S 05° E 18.85'
Nail & K.C. remon. tag on N side 12" Oak S 45° W 36.73'

Set a Kent County Reference Monument West 1319.35' of H-8
Nail & K.C. remon. tag on W side 12" Oak S 05° E 27.31'
Nail & K.C. remon. tag on NW side 8" Oak S 40° W 91.91'
Nail & K.C. remon. tag on N side 24" Oak N 80° W 86.55'
Nail & K.C. remon. tag on SW side 10" Oak N 50° W 48.59'
Nail & K.C. remon. tag on W side 10" Oak N 15° E 57.57'
Iron Pipe N 05° E 1.10'
C/L "X" of Connelly Ave. & Elkins Rd. 25' W and 15' S

STATE OF MICHIGAN
COUNTY OF KENT
RECEIVED FOR RECORD
1999 DEC 27 AM 8:19
REG. OF DEEDS

11645

Register of Deeds Stamp & File Number

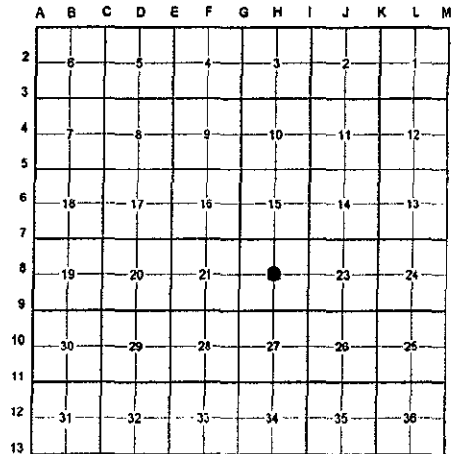

P.A. 345 1990 KENT COUNTY
PEER APPROVED 12/20/99
CHAIRMAN Randy Kolehouse

Signed by Randy J. Kolehouse
WILLIAMS & WORKS

Date 12-20-99

Surveyor's Michigan License No. 25854

