

MAY 22 2000

SECTION

LAND CORNER RECORDATION CERTIFICATE
Filing Requirement of Act 74, Mich. P.A. 1970
KENT COUNTY REMONUMENTATION

For corners in


Kent (County)	Located in: Oakfield Township	Corner Code #
1. Public Land Survey	T 9N R 9W	H-9
	T R	
	T R	
	T R	
2. Property Controlling in Section	S T R	
	S T R	
3. Miscellaneous Property in Sec.	S T R	
	S T R	

4. Lot No. _____; Recorded Plat _____
5. Private Claims _____

STATE OF MICHIGAN
COUNTY OF KENT
RECEIVED FOR RECORD
1999 OCT 27 AM 8:38
REG. OF DEEDS
11439
Register of Deeds Stamp & File Number

I, Randy Kolehouse, in a field survey on March 16 19 99, do hereby certify that under requirements of P.A. 74 Michigan P.A. of 1970, the corner points mentioned in lines 1 and 2 above were in conformance with regulations and rules therefore as required in the current manual of survey instructions of the United States Department of the Interior, Bureau of Land Management or by a decree of a Court of Law and/or that the corner points mentioned in lines 3, 4 and 5 above were in conformance with the rules of the Michigan Board of Land Surveyors or by a Decree of a Court of Law, established, re-established, monumented, re-monumented, recovered, found as expressed below:

NOTE: Not more than 4 corners, all in the same town and range, may be recorded on this certificate.

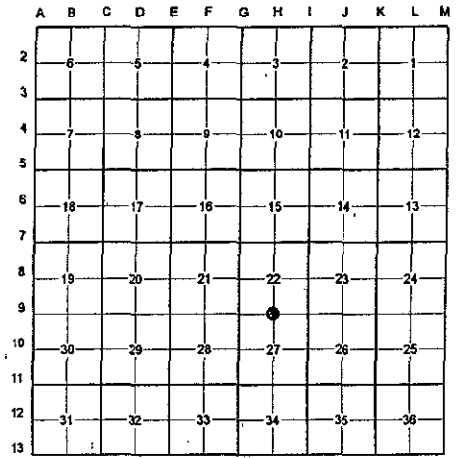

A. Description of original monument and accessories and/or subsequent restoration:

H-9	1837	G.L.O. Notes	Cathcart	Set Post	P.A. 345 1990 KENT COUNTY PEER APPROVED 7/29/99 CHAIRMAN <u>[Signature]</u>
	1974	L.C.R.C. #677	Medema Van Kooten	3/4" Iron	
	1981	L.C.R.C. #1672	Williams & Works	Fnd. Iron / Set K.C. Monument	
	1994	L.C.R.C. #7211	Glaza & Associates	K.C. Monument	

This corner was originally approved by the Kent County Remonumentation Peer Group and monumented by Williams & Works on 4/14/81 and was recorded per L.C.R.C. #1672.

B. Description of corner evidence found and/or method applied in restoring or reestablishing corner:

H-9 Found a Standard Kent County Monument on the C/L of 12 Mile Road (gravel) running East and the C/L of Connelly Avenue (gravel) running North per L.C.R.C.'s #1672 and #7211 as set by Williams & Works in place of a 3/4" iron they found which checked L.C.R.C. #677.

L.C.R.C. #1672

K.C. Remon. tag and nail in SW side 10" Oak E. 79.10'
K.C. Remon. tag and nail in S side 12" Oak N.85°E. 65.40'
K.C. Remon. tag and nail in W side 8" Pine N.20°E. 69.20'
K.C. Remon. tag and nail in S side 24" Pine N.45°W. 30.84'
On center line Connelly (gravel) North and on centerline 12 Mile (gravel) East

L.C.R.C. #7211

K.C. remon. tag & nail in SW side 14" Oak East 79.10' (m. 88.12')
On centerline Connelly (gravel) North and on centerline 12 Mile (gravel) East
K.C. remon tag & nail in SW side 26" Pine N40°W 30.54' (m. 30.56')
K.C. remon tag & nail in S side 16" Oak N85°E 65.53' (m. 65.57')
K.C. remon tag & nail in W side 10" Pine N20°E 69.03' (m. 69.11')
K.C. remon tag & nail in E side 14" Oak S18°E 15.90' (m. 15.93')

The selected location is accepted by me and is generally accepted by professional surveyors as the best available evidence of the position of the original corner.

C. Description of monument for corner and accessories established to perpetuate locating the position of the corner:

H-9 Standard Kent County Monument

Nail & K.C. remon. tag on SW side 10" Oak N 45° W 9.38'
Nail & K.C. remon. tag on S side 12" Oak N 90° E 88.12'
Nail & K.C. remon. tag on SW side 26" Pine N 40° W 30.56'
Nail & K.C. remon. tag on S side 16" Oak N 85° E 65.57'
Nail & K.C. remon. tag on W side 10" Pine N 20° E 69.11'
Nail & K.C. remon. tag on E side 14" Oak S 18° 15.93'
On C/L of gravel road running E
On C/L of gravel road running N



Signed by Randy J. Kolehouse Date 10-11-99
WILLIAMS & WORKS
Surveyor's Michigan License No. 25854