

MAY 22 2000

LAND CORNER RECORDATION CERTIFICATE
Filing Requirement of Act 74, Mich. P.A. 1970
KENT COUNTY REMONUMENTATION

For corners in SECTION
Kent
(County)

Located in: Oakfield Township Corner Code #
1. Public Land Survey T 9N R 9W H-11
T _____ R _____
T _____ R _____
T _____ R _____
2. Property Controlling S _____ T _____ R _____
in Section S _____ T _____ R _____
3. Miscellaneous S _____ T _____ R _____
Property in Sec. S _____ T _____ R _____

REG. OF DEEDS

STATE OF MICHIGAN
COUNTY OF KENT
RECEIVED FOR RECORD
1999 OCT 27 AM 8:38

11440

Register of Deeds Stamp & File Number

4. Lot No. _____, Recorded Plat _____
5. Private Claims _____

I, Randy Kolehouse, in a field survey on July 15 19 99, do hereby certify that under requirements of P.A. 74 Michigan P.A. of 1970, the corner points mentioned in lines 1 and 2 above were in conformance with regulations and rules therefore as required in the current manual of survey instructions of the United States Department of the interior, Bureau of Land Management or by a decree of a Court of Law and/or that the corner points mentioned in lines 3, 4 and 5 above were in conformance with the rules of the Michigan Board of Land Surveyors or by a Decree of a Court of Law; established, re-established, monumented, re-monumented, recovered, found as expressed below:

NOTE: Not more than 4 corners, all in the same town and range, may be recorded on this certificate.

A. Description of original monument and accessories and/or subsequent restoration:

H-11 1837	G.L.O. Notes	Cathcart	Set Post
1909-1968	Notes	Williams & Works	Fence Post in Swamp
1989	L.C.R.C. #5693	Kevin Roosien	Set K.C. Monument
1994	L.C.R.C. #7212	Glaza & Associates	K.C. Monument

P.A. 345 1990 KENT COUNTY
PEER APPROVED 7/29/99
CHAIRMAN Harry Faber

A	B	C	D	E	F	G	H	I	J	K	L	M
2	6	5	4	3	2	1						
3												
4	7	8	9	10	11	12						
5												
6	18	17	16	15	14	13						
7												
8	19	20	21	22	23	24						
9												
10	30	29	28	27	26	25						
11												
12	31	32	33	34	35	36						
13												

This corner was originally approved by the Kent County Remonumentation Peer Group and monumented by Kevin Roosien in 1989 and was recorded per L.C.R.C. 5693.

B. Description of corner evidence found and/or method applied in restoring or reestablishing corner:

H-11 Found a Standard Kent County Monument 100' ± East of the West edge of a swamp per L.C.R.C.'s #5693 and #7212 as set by Kevin Roosien using the 1909-1968 notes of Williams & Works.

L.C.R.C. #5693

L.C.R.C. #7212

K.C. Nail in tag in West side of 10" Ash N15°W 83.69'
K.C. Nail in tag in S. side of 5" Ash S80°E 28.92'
K.C. Nail in tag in NE side of 5" Ash S20°E 19.99'
K.C. Nail in tag in East side of 34" Oak West 176.77'


Nail & K.C. remon tag in W side 10" Ash N15°W 83.69' (m. 83.70')
Nail & K.C. remon tag in S side 5" Ash S80°E 28.90' (m. 28.94')
Nail & K.C. remon tag in NE side 7" Ash S20°E 19.99' (m. 19.92')
Nail & K.C. remon tag in E side 34" Oak West 176.77' (m. 177.10')

The selected location is accepted by me and is generally accepted by professional surveyors as the best available evidence of the position of the original corner.

C. Description of monument for corner and accessories established to perpetuate locating the position of the corner:

H-11 Standard Kent County Monument

Nail & K.C. remon. tag on W side 10" Ash N 15° W 83.70'
Nail & K.C. remon. tag on S side 6" Ash S 80° E 28.94'
Nail & K.C. remon. tag on NE side 7" Ash S 20° E 19.92'
Nail & K.C. remon. tag on N side 34" Oak N 90° W 177.10'

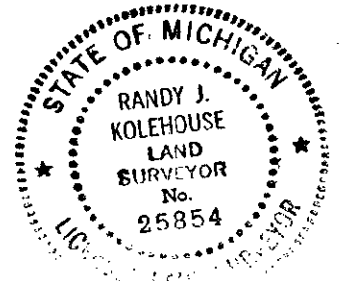

Signed by Randy J. Kolehouse
WILLIAMS & WORKS

Date 10-11-99

Surveyor's Michigan License No. 25854