

MAY 22 2000

\$7.00
\$2.00

SECTION

LAND CORNER RECORDATION CERTIFICATE
Filing Requirement of Act 74, Mich. P.A. 1970
KENT COUNTY REMONUMENTATION

For corners in

Kent (County)	Located in: Oakfield Township	Corner Code #
1. Public Land Survey	T <u>9N</u> R <u>9W</u>	<u>H-12</u>
	T _____ R _____	_____
	T _____ R _____	_____
	T _____ R _____	_____
2. Property Controlling in Section	S _____ T _____ R _____	_____
	S _____ T _____ R _____	_____
3. Miscellaneous Property in Sec.	S _____ T _____ R _____	_____
	S _____ T _____ R _____	_____

REG. OF DEEDS

[Signature]


1999 DEC 27 AM 8:19

STATE OF MICHIGAN
COUNTY OF KENT
RECEIVED FOR RECORD

11646

Register of Deeds Stamp & File Number

- 4. Lot No. _____, Recorded Plat _____
- 5. Private Claims _____

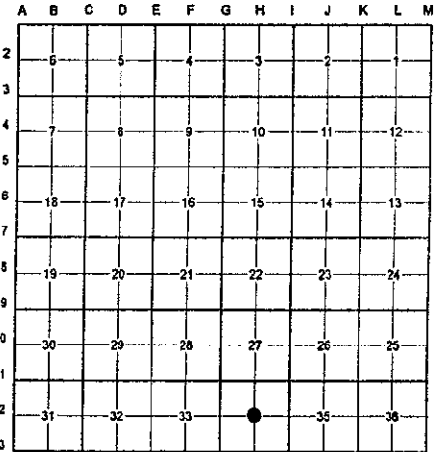

I, Randy Kolehouse, in a field survey on December 16 19 99, do hereby certify that under requirements of P.A. 74 Michigan P.A. of 1970, the corner points mentioned in lines 1 and 2 above were in conformance with regulations and rules therefore as required in the current manual of survey instructions of the United States Department of the interior, Bureau of Land Management or by a decree of a Court of Law and/or that the corner points mentioned in lines 3, 4 and 5 above were in conformance with the rules of the Michigan Board of Land Surveyors or by a Decree of a Court of Law; established, re-established, monumented, re-monumented, recovered, found as expressed below:

NOTE: Not more than 4 corners, all in the same town and range, may be recorded on this certificate.

A. Description of original monument and accessories and/or subsequent restoration:

H-12 This corner was not originally set by the G.L.O.
No information on record.

P.A. 345 1990 KENT COUNTY

PEER APPROVED 12/02/99
CHAIRMAN [Signature]


B. Description of corner evidence found and/or method applied in restoring or reestablishing corner:

H-12 Found no evidence of this corner. Set point at the intersection of 1/4 lines in an orchard (no occupation).

The selected location is accepted by me and is generally accepted by professional surveyors as the best available evidence of the position of the original corner.

C. Description of monument for corner and accessories established to perpetuate locating the position of the corner:

- H-12 Set a Standard Kent County Monument
- Nail & K.C. remon. tag on W side post S 30° E 34.68'
- Nail & K.C. remon. tag on W side post S 05° E 30.58'
- Nail & K.C. remon. tag on E side post S 30° W 33.65'
- Nail & K.C. remon. tag on SE side post S 50° W 43.10'
- C/L 3" Apple S 80° W 14.45' (0.5' above ground)
- C/L 4" Apple N 03° E 12.10' (0.5' above ground)
- C/L 4" Apple N 60° E 1.50' (0.5' above ground)

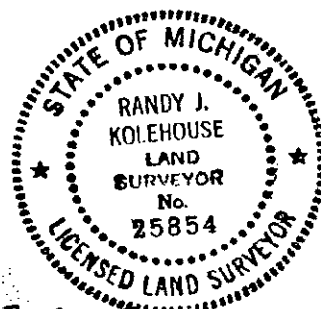

Signed by Randy J. Kolehouse
WILLIAMS & WORKS

Date 12-20-99

Surveyor's Michigan License No. 25854