

MAY 22 2000

\$7.00  
\$2.00

SECTION

LAND CORNER RECORDATION CERTIFICATE  
Filing Requirement of Act 74, Mich. P.A. 1970  
KENT COUNTY REMONUMENTATION

For corners in

Kent (County)	Located in:	Oakfield Township	Corner Code #
1. Public Land Survey	T <u>9N</u>	R <u>9W</u>	<u>I-1</u>
	T _____	R _____	_____
	T _____	R _____	_____
	T _____	R _____	_____
2. Property Controlling in Section	S _____	T _____	R _____
	S _____	T _____	R _____
3. Miscellaneous Property in Sec.	S _____	T _____	R _____
	S _____	T _____	R _____

REG. OF DEEDS

*[Signature]*

STATE OF MICHIGAN  
COUNTY OF KENT  
RECEIVED FOR RECORD  
1999 DEC - 8 AM 10: 07

11562

Register of Deeds Stamp & File Number

- 4. Lot No. \_\_\_\_\_, Recorded Plat \_\_\_\_\_
- 5. Private Claims \_\_\_\_\_

	A	B	C	D	E	F	G	H	I	J	K	L	M
2													
3													
I, Randy Kolehouse, in a field survey on September 7 19 99, do hereby certify that under requirements of P.A. 74 Michigan P.A. of 1970, the corner points mentioned in lines 1 and 2 above were in conformance with regulations and rules therefore as required in the current manual of survey instructions of the United States Department of the interior, Bureau of Land Management or by a decree of a Court of Law and/or that the corner points mentioned in lines 3, 4 and 5 above were in conformance with the rules of the Michigan Board of Land Surveyors or by a Decree of a Court of Law; established, re-established, monumented, re-monumented, recovered, found as expressed below:

NOTE: Not more than 4 corners, all in the same town and range, may be recorded on this certificate.

A. Description of original monument and accessories and/or subsequent restoration: P.A. 345 1990 KENT COUNTY  
 I-1 1837 G.L.O. Notes Cathcart Set Post PEER APPROVED 10/28/99  
 N/A Witness Map K.C. Surveyor 1" Iron CHAIRMAN *[Signature]*  
 1980 L.C.R.C. #1337 Glen Hackbardt Mon. Box  
 1989 L.C.R.C. #5160 John Bueche Fnd. Mon. Box / Set K.C. Monument in Mon. Box  
 1997 L.C.R.C. #9983 Kirk Breitels K.C. Monument

Note: This corner is not common with I-13, T10N, R9W.

This corner was originally approved by the Kent County Reimonumentation Peer Group and monumented by John Bueche on 5/22/89 and was recorded per L.C.R.C. #5160.

B. Description of corner evidence found and/or method applied in restoring or reestablishing corner:

I-1 Found a Standard Kent County Monument 1' ± West of the C/L of Lincoln Lake Avenue (bit.) running North and South and 6' ± North of the C/L of 16 Mile Road (bit.) running East and West per L.C.R.C.'s #5160 and #9983 as set by John Bueche in place of a monument box he found which checked L.C.R.C. #1337 and the K.C. Surveyor's records.

L.C.R.C. #5160

L.C.R.C. #9983

Nail & Remon. Tag in W. side dbl. 20" Oak Pine S 20° W 156.05'  
SE cor. hse. fnd. N 50° W 110.85'  
NE cor. conc. for pad MBT box S 60° W 44.43'  
K.C. Mon. (I-13 10-9) East 89.05'


Nail & KC Remon. tag W. side 22" Pine S20°W 156.14' (m. 156.17')  
Nail & KC Remon. tag E. side P. Pole N25°E 170.43' (m. 170.35')  
SE corner house foundation N50°W 110.95' (m. 110.80')  
PK Nail E. side Utility Pole N30°W 149.61' (m. 149.64')  
KC Mon. (I-13, 10-9) East 89.03'

The selected location is accepted by me and is generally accepted by professional surveyors as the best available evidence of the position of the original corner.

C. Description of monument for corner and accessories established to perpetuate locating the position of the corner:

I-1 Standard Kent County Monument

Nail & K.C. remon. tag on W side 22" Pine S 20° W 156.17'  
Nail & K.C. remon. tag on E side P. pole N 25° E 170.35'  
SE cor. hse. fndn. N 50° W 110.80'  
Nail & K.C. remon. tag on E side Utility pole N 30° W 149.64'  
C/L of bit. road running N-S, East 1' ±  
C/L of bit. road running E-W, South 6' ±  
K.C. Mon., I-13, T10N, R9W, East 89.03'

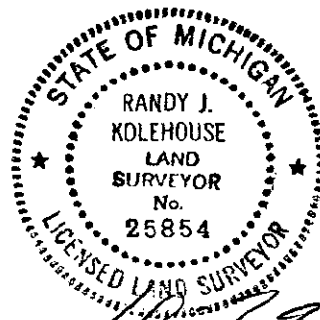

Signed by *[Signature]* Date 10-29-99  
WILLIAMS & WORKS  
Surveyor's Michigan License No. 25854