

MAY 22 2000

\$7.00
\$2.00

SECTION

LAND CORNER RECORDATION CERTIFICATE

Filing Requirement of Act 74, Mich. P.A. 1970

KENT COUNTY REMONUMENTATION

For corners in

Kent (County)	Located in:	Oakfield Township	Corner Code #
1. Public Land Survey	T 9N	R 9W	I-2
	T	R	
	T	R	
	T	R	
2. Property Controlling in Section	S	T	R
	S	T	R
3. Miscellaneous Property in Sec.	S	T	R
	S	T	R
4. Lot No. _____, Recorded Plat _____			
5. Private Claims _____			

REG. OF DEEDS

[Signature]

STATE OF MICHIGAN
COUNTY OF KENT
RECEIVED FOR RECORD
1999 DEC - 8 AM 10: 07

11563

Register of Deeds Stamp & File Number

I, Randy Kolehouse, in a field survey on August 16 19 99, do hereby certify that under requirements of P.A. 74 Michigan P.A. of 1970, the corner points mentioned in lines 1 and 2 above were in conformance with regulations and rules therefore as required in the current manual of survey instructions of the United States Department of the interior, Bureau of Land Management or by a decree of a Court of Law and/or that the corner points mentioned in lines 3, 4 and 5 above were in conformance with the rules of the Michigan Board of Land Surveyors or by a Decree of a Court of Law; established, re-established, monumented, re-monumented, recovered, found as expressed below:

NOTE: Not more than 4 corners, all in the same town and range, may be recorded on this certificate.

A	B	C	D	E	F	G	H	I	J	K	L	M
2	6	5	4	3	2	1						
3												
4	7	6	5	4	3	2	1					
5												
6	10	9	8	7	6	5	4	3	2	1		
7												
8	13	12	11	10	9	8	7	6	5	4	3	2
9												
10	16	15	14	13	12	11	10	9	8	7	6	5
11												
12	19	18	17	16	15	14	13	12	11	10	9	8
13												

A. Description of original monument and accessories and/or subsequent restoration:

I-2	1837	G.L.O. Notes	Cathcart	Set Post
	N/A	Witness Map	K.C. Surveyor	Iron in Mon. Box
	1983	L.C.R.C. #3332	Glaza & Associates	N/A
	1984	L.C.R.C. #3732	Williams & Works	Fnd. 3/4" Iron Pipe in Mon. Box / Set K.C. Mon. in Mon. Box
	1994	L.C.R.C. #7215	Glaza & Associates	K.C. Monument

P.A. 345 1990 KENT COUNTY

PEER APPROVED 10/28/99
CHAIRMAN [Signature]

This corner was originally approved by the Kent County Remonumentation Peer Group and monumented by Williams & Works on 1/30/84 and was recorded per L.C.R.C. #3732.

B. Description of corner evidence found and/or method applied in restoring or reestablishing corner:

I-2 Found a Standard Kent County Monument at the C/L intersection of Lincoln Lake Avenue (bit.) running North and South and MacClain Street (bit.) running East and West per L.C.R.C.'s #3732 and #7215 as set by Williams & Works in place of a 3/4" iron pipe they found in a monument box which checked L.C.R.C. #3332 and the K.C. Surveyor's records.

L.C.R.C. #3732

L.C.R.C. #7215

Nail & KC Remon.tag in E'ly face cor.fence post S.42°W. 72.80'
Nail & KC Remon.tag in E'ly face 14" Pine N.28°W. 98.25'
SW cor. conc. block house N.36°E. 120.81'
Nail & KC Remon.tag in W'ly face power pole N.46°E. 49.70'


Nail & K.C. remon tag in E'ly side corner fence post S42°W 72.73'
Nail & K.C. remon tag in E'ly side 14" Pine N28°W 98.18'
SW corner concrete block house N36°E 120.78'
Nail & K.C. remon tag in NW side P. pole N46°E 49.78'
NW corner concrete block garage S45°E 133.97'

The selected location is accepted by me and is generally accepted by professional surveyors as the best available evidence of the position of the original corner.

C. Description of monument for corner and accessories established to perpetuate locating the position of the corner:

I-2 Standard Kent County Monument

Nail & K.C. remon. tag on E face cor. fence post S 42° W 72.73'
Nail & K.C. remon. tag on E face 14" Pine N 28° W 98.18'
Nail & K.C. remon. tag on NW face P. pole N 46° E 49.78'
SW cor. conc. block bldg. (party store) N 36° E 120.78'
NW cor. conc. block fndn. to new garage S 45° E 133.97'
On C/L "X" of bit. roads running N-S & E-W

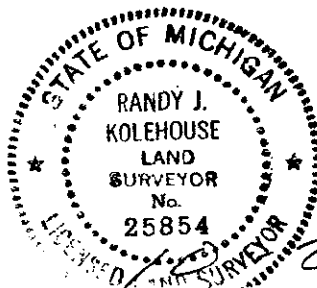

Signed by Randy J. Kolehouse Date 10-29-99

WILLIAMS & WORKS

Surveyor's Michigan License No. 25854