

MAY 22 2000

\$7.00  
\$2.00

SECTION

LAND CORNER RECORDATION CERTIFICATE  
Filing Requirement of Act 74, Mich. P.A. 1970  
KENT COUNTY REMONUMENTATION

STATE OF MICHIGAN  
COUNTY OF KENT  
RECEIVED FOR RECORD  
1999 DEC - 8 AM 10:07

REG. OF DEEDS  
*[Signature]*

11565

Register of Deeds Stamp & File Number


For corners in

Kent (County)	Located in: Oakfield Township	Corner Code #
1. Public Land Survey	T 9N R 9W	I-4
	T R	
	T R	
	T R	
2. Property Controlling in Section	S T R	
	S T R	
3. Miscellaneous Property in Sec.	S T R	
	S T R	

- 4. Lot No. \_\_\_\_\_, Recorded Plat \_\_\_\_\_
- 5. Private Claims \_\_\_\_\_

I, Randy Kolehouse, in a field survey on September 7 19 99, do hereby certify that under requirements of P.A. 74 Michigan P.A. of 1970, the corner points mentioned in lines 1 and 2 above were in conformance with regulations and rules therefore as required in the current manual of survey instructions of the United States Department of the interior, Bureau of Land Management or by a decree of a Court of Law and/or that the corner points mentioned in lines 3, 4 and 5 above were in conformance with the rules of the Michigan Board of Land Surveyors or by a Decree of a Court of Law; established, re-established, monumented, re-monumented, recovered, found as expressed below.

NOTE: Not more than 4 corners, all in the same town and range, may be recorded on this certificate.

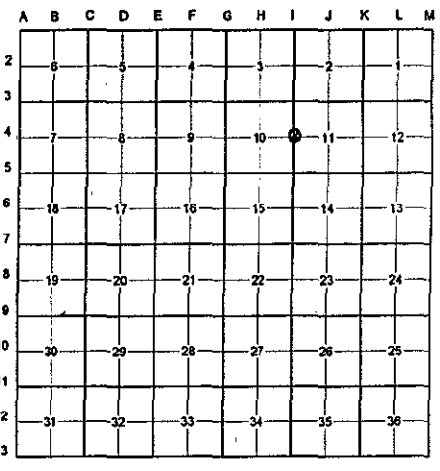

A. Description of original monument and accessories and/or subsequent restoration:

I-4	1837	G.L.O. Notes	Cathcart	Set Post
	N/A	Witness Map	K.C. Surveyor	Iron
	1979	L.C.R.C. #1275	Williams & Works	R.R. Spike
	1981	L.C.R.C. #1665	Williams & Works	Fnd. R.R. Spike / Set K.C. Monument
	1994	L.C.R.C. #7217	Glaza & Associates	K.C. Monument

P.A. 345 1990 KENT COUNTY  
PEER APPROVED 10/28/99  
CHAIRMAN [Signature]

This corner was originally approved by the Kent County Remonumentation Peer Group and monumented by Williams & Works on 4/16/81 and was recorded per L.C.R.C. #1665.

B. Description of corner evidence found and/or method applied in restoring or reestablishing corner:

I-4 Found a Standard Kent County Monument 1.5' ± West of the C/L of Lincoln Lake Avenue (bit.) running North and South, on line of a tree row running West, per L.C.R.C.'s #1665 and #7217 as set by Williams & Works in place of a railroad spike they found which checked L.C.R.C. #1275 and the K.C. Surveyor's records.

L.C.R.C. #1665

L.C.R.C. #7217


- K.C. Remon. tag and nail in N. side 12" Pine W. 24.68'
- K.C. Remon. tag and nail in SE side 12" Pine S.45°W. 35.98'
- K.C. Remon. tag and nail in NE side 12" Pine S.45°E. 43.76'
- K.C. Remon. tag and nail in NE side 12" Pine N.40°W. 36.50'
- K.C. Remon. tag and nail in W. side 16" Pine S.15°E. 106.03'
- K.C. Remon. tag and nail in NW side Power pole N.35°E. 124.79'
- Center line Lincoln Lake Ave. East 1.5'

- K.C. remon tag & nail in N side 15" Pine West 24.66'
- K.C. remon tag & nail in SE side 20" Pine S45°W 35.99'
- K.C. remon tag & nail in NE side 16" Pine S45°E 43.80' (m. 43.76')
- K.C. remon tag & nail in W side 18" Pine S15°E 106.03' (m. 106.00')
- K.C. remon tag & nail in NW side P. pole N35°E 124.79' (m. 124.82')
- Centerline Lincoln Lake Avenue East 1.5'

The selected location is accepted by me and is generally accepted by professional surveyors as the best available evidence of the position of the original corner.

C. Description of monument for corner and accessories established to perpetuate locating the position of the corner:

- I-4 Standard Kent County Monument
- Nail & K.C. remon. tag on N face 15" Pine West 24.66'
- Nail & K.C. remon. tag on SE face 20" Pine S 45° W 35.99'
- Nail & K.C. remon. tag on N face 16" Pine S 45° E 43.76'
- Nail & K.C. remon. tag on W face 18" Pine S 15° E 106.00'
- Nail & K.C. remon. tag on NW face P. pole N 35° E 124.82'
- C/L of bit. road running N-S, East 1.5'
- On tree row running W

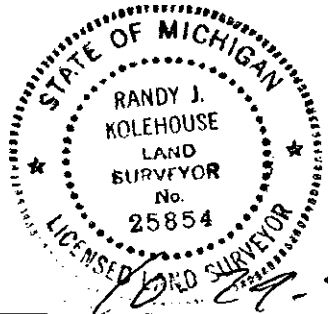

Signed by [Signature] Date 10-29-99

WILLIAMS & WORKS

Surveyor's Michigan License No. 25854