

MAY 22 2000

\$7.00  
\$2.00

SECTION

LAND CORNER RECORDATION CERTIFICATE  
Filing Requirement of Act 74, Mich. P.A. 1970  
KENT COUNTY REMONUMENTATION

For corners in

| Kent<br>(County)                      | Located in:<br>Oakfield<br>Township | Corner Code # |
|---------------------------------------|-------------------------------------|---------------|
| 1. Public Land Survey                 | T <u>9N</u> R <u>9W</u>             | <u>I-5</u>    |
|                                       | T _____ R _____                     | _____         |
|                                       | T _____ R _____                     | _____         |
|                                       | T _____ R _____                     | _____         |
| 2. Property Controlling<br>in Section | S _____ T _____ R _____             | _____         |
|                                       | S _____ T _____ R _____             | _____         |
| 3. Miscellaneous<br>Property in Sec.  | S _____ T _____ R _____             | _____         |
|                                       | S _____ T _____ R _____             | _____         |

REG. OF DEEDS


*[Handwritten Signature]*

STATE OF MICHIGAN  
COUNTY OF KENT  
RECEIVED FOR RECORD  
1999 DEC - 8 AM 10:07

11566

Register of Deeds Stamp & File Number

- 4. Lot No. \_\_\_\_\_, Recorded Plat \_\_\_\_\_
- 5. Private Claims \_\_\_\_\_

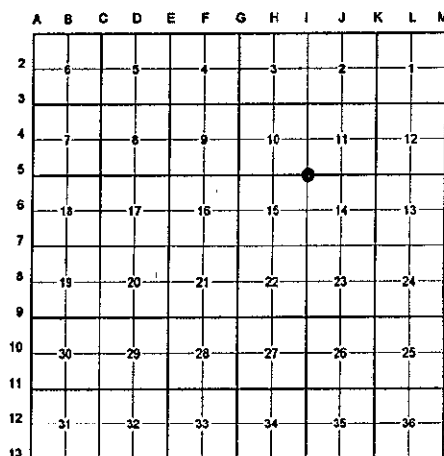

I, Randy Kolehouse, in a field survey on September 7 19 99, do hereby certify that under requirements of P.A. 74 Michigan P.A. of 1970, the corner points mentioned in lines 1 and 2 above were in conformance with regulations and rules therefore as required in the current manual of survey instructions of the United States Department of the interior, Bureau of Land Management or by a decree of a Court of Law and/or that the corner points mentioned in lines 3, 4 and 5 above were in conformance with the rules of the Michigan Board of Land Surveyors or by a Decree of a Court of Law; established, re-established, monumented, re-monumented, recovered, found as expressed below:

NOTE: Not more than 4 corners, all in the same town and range, may be recorded on this certificate.

A. Description of original monument and accessories and/or subsequent restoration:

|     |         |                |                     |   |
|-----|---------|----------------|---------------------|---|
| I-5 | 1837    | G.L.O. Notes   | Cathcart            | Set Post  |
|     | 1946    | Records        | Williams & Works    | Iron  |
|     | 1932-63 | Witness Map    | K.C. Surveyor       | 1" Iron in Mon. Box                               |
|     | 1983    | L.C.R.C. #3330 | Glaza & Associates  | N/A   |
|     | 1985    | L.C.R.C. #4148 | Thomas Chettleburgh | Fnd. 1" Iron Pipe in Mon. Box / Set K.C. Monument |
|     | 1994    | L.C.R.C. #7218 | Glaza & Associates  | K.C. Monument                                     |

P.A. 345 1990 KENT COUNTY

PEER APPROVED 10/28/99

CHAIRMAN [Signature]

This corner was originally approved by the Kent County Remonumentation Peer Group and monumented by Thomas Chettleburgh on 4/2/85 and was recorded per L.C.R.C. #4148.

B. Description of corner evidence found and/or method applied in restoring or reestablishing corner:

I-5 Found a Standard Kent County Monument at the C/L intersection of Lincoln Lake Avenue (bit.) running North and South and 14 Mile Road (bit.) running East and West per L.C.R.C.'s #4148 and #7218 as set by Thomas Chettleburgh in place of a 1" iron pipe he found in a monument box which checked L.C.R.C. #3330, the 1946 records of Williams & Works, and the K.C. Surveyor's records.

L.C.R.C. #4148

L.C.R.C. #7218

Nail/tag in NW side Power Pole N41E 112.10'  
Nail/tag in NE side 17" Oak S49E 150.20'  
Nail/tag in NW side Power Pole S33W 72.78'  
Nail/tag in E side Power Pole N18W 120.55'


K.C. remon tag & nail in NW side P. pole N41°E 112.10' (m. 112.13')  
K.C. remon tag & nail in NE side 20" Oak S49°E 150.13' (m. 150.16')  
K.C. remon tag & nail in NW side P. pole S33°W 72.79'  
K.C. remon-tag & nail in E side P. pole N18°W 120.53' (m. 120.57')

The selected location is accepted by me and is generally accepted by professional surveyors as the best available evidence of the position of the original corner.

C. Description of monument for corner and accessories established to perpetuate locating the position of the corner:

I-5 Standard Kent County Monument

Nail & K.C. remon. tag on NW side P. pole N 41° E 112.13'  
Nail & K.C. remon. tag on NE side 20" Oak S 49° E 150.16'  
Nail & K.C. remon. tag on NW side P. pole S 33° W 72.79'  
Nail & K.C. remon. tag on E side P. pole N 18°W 120.57'  
On C/L "X" of bit. roads running N-S & E-W

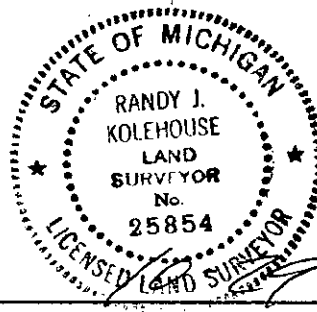

Signed by Randy J. Kolehouse Date \_\_\_\_\_

WILLIAMS & WORKS

Surveyor's Michigan License No. 25854