

MAY 22 2000

LAND CORNER RECORDATION CERTIFICATE
Filing Requirement of Act 74, Mich. P.A. 1970
KENT COUNTY REMONUMENTATION

For corners in SECTION


Table with columns: Kent (County), Located in: Oakfield Township, Corner Code #. Rows include Public Land Survey, Property Controlling in Section, and Miscellaneous Property in Sec.

Register of Deeds Stamp & File Number. Includes vertical text: STATE OF MICHIGAN COUNTY OF KENT RECEIVED FOR RECORD 1999 OCT 27 AM 8:38. File number: 11441.

- 4. Lot No. Recorded Plat
5. Private Claims

I, Randy Kolehouse, in a field survey on March 23 19 99, do hereby certify that under requirements of P.A. 74 Michigan P.A. of 1970, the corner points mentioned in lines 1 and 2 above were in conformance with regulations and rules therefore as required in the current manual of survey instructions of the United States Department of the interior, Bureau of Land Management or by a decree of a Court of Law and/or that the corner points mentioned in lines 3, 4 and 5 above were in conformance with the rules of the Michigan Board of Land Surveyors or by a Decree of a Court of Law; established, re-established, monumented, re-monumented, recovered, found as expressed below:

NOTE: Not more than 4 corners, all in the same town and range, may be recorded on this certificate.

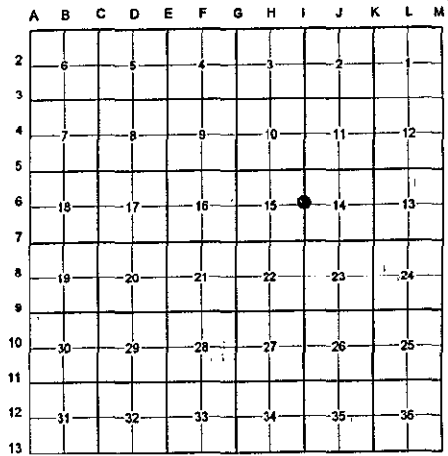

A. Description of original monument and accessories and/or subsequent restoration:

Table with columns: I-6, 1837, G.L.O. Notes, Cathcart, Set Post. Rows list survey dates and monument types like Iron Bar / Stones, Iron in Mon. Box, 3/4" Iron, Fnd. 1/2" Iron Pipe / Set K.C. Monument, K.C. Monument.

P.A. 345 1990 KENT COUNTY PEER APPROVED 7/29/99 CHAIRMAN [Signature]

This corner was originally approved by the Kent County Remonumentation Peer Group and monumented by Thomas Chettleburgh on 4/2/85 and was recorded per L.C.R.C. #4149.

B. Description of corner evidence found and/or method applied in restoring or reestablishing corner:

I-6 Found a Standard Kent County Monument in a monument box 1' East of the C/L of Lincoln Lake Avenue (bit.) running North and South per L.C.R.C.'s #4149 and #7219 as set by Thomas Chettleburgh in place of a 1/2" iron he found which checked L.C.R.C. #3333 and the K.C. Surveyor's records.

L.C.R.C. #4149

L.C.R.C. #7219

- Nail/tag in W side 15" Oak N24E 78.00'
Nail/tag in NW 17" Oak N44E 45.41'
Nail/tag in NW side 18" Oak N60E 37.51'
Nail/tag in S side 12", 11" Oak N85W 44.19'
Nail/tag in E side 11" Pine N20W 77.98'


- Nail & K.C. remon tag in W side 18" Oak N24°E 78.02' (m. 77.99')
Nail & K.C. remon tag in NW side 17" Oak N44°E 45.43' (m. 45.39')
Nail & K.C. remon tag in NW side 18" Oak N60°E 37.47' (m. 37.46')
Nail & K.C. remon tag in S side 14", 12" Oak N85°W 44.22' (m. 44.21')
Nail & K.C. remon tag in E side 12" Pine N20°W 77.98'
C/L N-W road 1'+/- West

The selected location is accepted by me and is generally accepted by professional surveyors as the best available evidence of the position of the original corner.

C. Description of monument for corner and accessories established to perpetuate locating the position of the corner:

I-6 Standard Kent County Monument in a Monument Box

- Nail & K.C. remon. tag on W side 18" Oak N 24° E 77.99'
Nail & K.C. remon. tag on NW side 17" Oak N 44° E 45.39'
Nail & K.C. remon. tag on NW side 18" Oak N 60° E 37.46'
Nail & K.C. remon. tag on S side 14"-12" twin Oak N 85° W 44.21'
Nail & K.C. remon. tag on E side 12" Pine N 20° W 77.98'
C/L of bit. road running N-S, West 1' ±

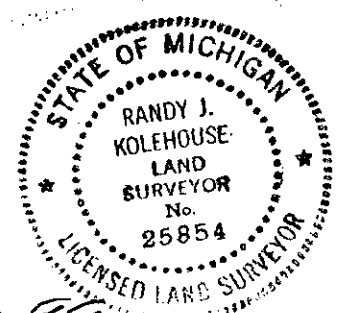

Signed by [Signature] Date 10-11-99
WILLIAMS & WORKS

Surveyor's Michigan License No. 25854