

\$7.00
\$2.00

MAY 28 2000

LAND CORNER RECORDATION CERTIFICATE
Filing Requirement of Act 74, Mich. P.A. 1970
KENT COUNTY REMONUMENTATION

For corners in

SECTION

Kent
(County)

Located in: Oakfield
Township

Corner Code #

- | | | | |
|------------------------------------|-------------|-------------|------------|
| 1. Public Land Survey | T <u>9N</u> | R <u>9W</u> | <u>I-8</u> |
| | T _____ | R _____ | _____ |
| | T _____ | R _____ | _____ |
| | T _____ | R _____ | _____ |
| 2. Property Controlling in Section | S _____ | T _____ | R _____ |
| | S _____ | T _____ | R _____ |
| 3. Miscellaneous Property in Sec. | S _____ | T _____ | R _____ |
| | S _____ | T _____ | R _____ |

STATE OF MICHIGAN
COUNTY OF KENT
RECEIVED FOR RECORD

1999 OCT 27 AM 8:38

REG. OF DEEDS


[Signature]

11443
Register of Deeds Stamp & File Number

4. Lot No. _____, Recorded Plat _____
5. Private Claims _____

I, Randy Kolehouse, in a field survey on March 23 19 99, do hereby certify that under requirements of P.A. 74 Michigan P.A. of 1970, the corner points mentioned in lines 1 and 2 above were in conformance with regulations and rules therefore as required in the current manual of survey instructions of the United States Department of the interior, Bureau of Land Management or by a decree of a Court of Law and/or that the corner points mentioned in lines 3, 4 and 5 above were in conformance with the rules of the Michigan Board of Land Surveyors or by a Decree of a Court of Law; established, re-established, monumented, re-monumented, recovered, found as expressed below:

NOTE: Not more than 4 corners, all in the same town and range, may be recorded on this certificate.

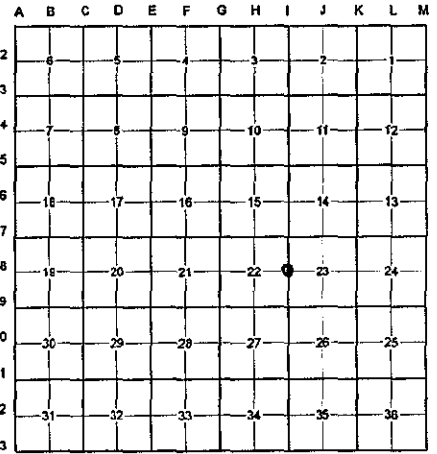

A. Description of original monument and accessories and/or subsequent restoration:

I-8	1837	G.L.O. Notes	Cathcart	Set Post
	1974	L.C.R.C. #676	Medema, Van Kooten	"T" Iron
	1981	L.C.R.C. #1664	Williams & Works	Fnd. "T" Iron / Set K.C. Monument
	1994	L.C.R.C. #7221	Glaza & Associates	K.C. Monument

P.A. 345 1990 KENT COUNTY
PEER APPROVED 7/29/99
CHAIRMAN *[Signature]*

This corner was originally approved by the Kent County Remonumentation Peer Group and monumented by Williams & Works on 4/16/81 and was recorded per L.C.R.C. #1664.

B. Description of corner evidence found and/or method applied in restoring or reestablishing corner:

I-8 Found a Standard Kent County Monument 1' ± East of the C/L of Lincoln Lake Avenue (bit.) running North and South, on line of a fence line running East and West, per L.C.R.C.'s #1664 and #7221 as set by Williams & Works in place of a "T" iron they found which checked L.C.R.C. #676.

L.C.R.C. #1664

L.C.R.C. #7221

K.C. Remon. tag and nail in NW side 12" Ash S.50°W. 40.20'
K.C. Remon. tag and nail in N. side 40" Oak N.80°W. 33.24'
K.C. Remon. tag and nail in SW side 18" Hickory N.40°W. 49.20'
K.C. Remon. tag and nail in NW side 10" Pine N.60°E. 51.60'
K.C. Remon. tag and nail in SW side 38" Oak S.40°E. 48.17'
On fence lines E. & W.


K.C. remon tag & nail in NW side 14" Ash S50°W 40.15' (m. 40.12')
K.C. remon tag & nail in N side 40" Oak N80°W 33.24' (m. 33.23')
K.C. remon tag & nail in SW side 30" Hickory N40°W 49.28' (m. 49.32')
K.C. remon tag & nail in NW side 14" Pine (6' above grnd) N60°E 52.14' (m. 52.12')
K.C. remon tag & nail in SW side 40" Oak S40°E 48.32' (m. 48.33')
On fence lines E & W
Centerline Lincoln Lake Ave. West 1'+/-

The selected location is accepted by me and is generally accepted by professional surveyors as the best available evidence of the position of the original corner.

C. Description of monument for corner and accessories established to perpetuate locating the position of the corner:

I-8 Standard Kent County Monument

Nail & K.C. remon. tag on NW side 14" Ash S 50° W 40.12'
Nail & K.C. remon. tag on N side 40" Oak N 80° W 33.23'
Nail & K.C. remon. tag on SW side 30" Hickory N 40° W 49.32'
Nail & K.C. remon. tag on NW side 14" Pine (6' above grnd.) N 60° E 52.12'
Nail & K.C. remon. tag on SW side 40" Oak S 40° E 48.33'
C/L of bit. road running N-S, West 1' ±
On fence line running E-W

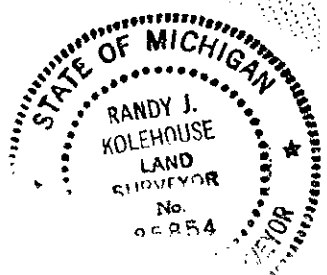

Signed by *[Signature]* Date 7-26-99

WILLIAMS & WORKS

Surveyor's Michigan License No. 25854