

MAY 22 2000

LAND CORNER RECORDATION CERTIFICATE
Filing Requirement of Act 74, Mich. P.A. 1970
KENT COUNTY REMONUMENTATION

For corners in SECTION Kent (County)

Located in: Oakfield Township Corner Code #

Table with 3 columns: Description (Public Land Survey, Property Controlling in Section, Miscellaneous Property in Sec.), Township (T, S), Range (R), and Corner Code #.

REG. OF DEEDS

Handwritten signature

STATE OF MICHIGAN COUNTY OF KENT RECEIVED FOR RECORD 1999 OCT 27 AM 8:38

11444

Register of Deeds Stamp & File Number


4. Lot No. Recorded Plat
5. Private Claims

I, Randy Kolehouse, in a field survey on March 23 19 99 do hereby certify that under requirements of P.A. 74 Michigan P.A. of 1970, the corner points mentioned in lines 1 and 2 above were in conformance with regulations and rules therefore as required in the current manual of survey instructions of the United States Department of the Interior, Bureau of Land Management or by a decree of a Court of Law and/or that the corner points mentioned in lines 3, 4 and 5 above were in conformance with the rules of the Michigan Board of Land Surveyors or by a Decree of a Court of Law; established, re-established, monumented, re-monumented, recovered, found as expressed below:

NOTE: Not more than 4 corners, all in the same town and range, may be recorded on this certificate.

A. Description of original monument and accessories and/or subsequent restoration:

Table with 4 columns: Corner Code #, Date, Surveyor/Notes, and Monument Description.

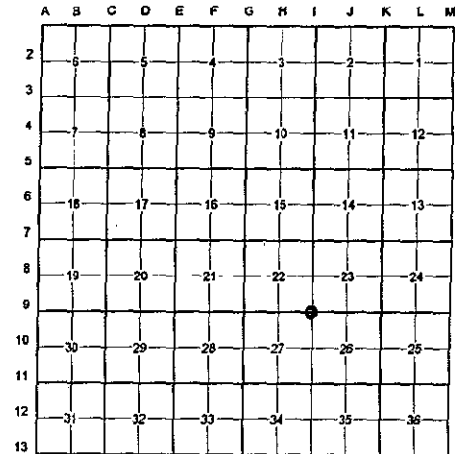

This corner was originally approved by the Kent County Remonumentation Peer Group and monumented by Williams & Works on 4/16/81 and was recorded per L.C.R.C. #1670.

B. Description of corner evidence found and/or method applied in restoring or reestablishing corner:

I-9 Found a Standard Kent County Monument at the C/L intersection of Lincoln Lake Avenue (bit.) running North and South and 12 Mile Road (gravel) running East and West per L.C.R.C.'s #1670 and #7222 as set by Williams & Works in place of a 1/2" iron and boat spike they found in a monument box 1.5' below ground which checked with L.C.R.C. #676.

L.C.R.C. #1670

L.C.R.C. #7222

"X" cut N end 18" conc. culvt. N.65°W. 53.61'
"X" cut S end 18" conc. culvt. S.60°W. 63.56'
"X" cut N end 18" conc. culvt. N.70°E. 54.94'
"X" cut S end 18" conc. culvt. S.60°E. 53.74'
Center line top conc. R.O.W. marker N.20°E. 121.43'

"X" cut in North end of 18" concrete culvert N65°W 53.61' (m. 53.62)
"X" cut in South end of 18" concrete culvert S60°W 63.56' (m. 63.63)
"X" cut in North end of 18" concrete culvert N70°E 54.94'
Centerline top concrete R.O.W. marker N20°E 121.43' (m. 121.30')
In centerline "X" of Lincoln Lake Ave and 12 Mile Rd.


The selected location is accepted by me and is generally accepted by professional surveyors as the best available evidence of the position of the original corner.

C. Description of monument for corner and accessories established to perpetuate locating the position of the corner:

I-9 Standard Kent County Monument
"X" cut North end 18" culvert N 65° W 53.62'
"X" cut North end 18" culvert N 70° E 54.94'
"X" cut South end 18" culvert S 60° W 63.63'
"X" cut South end 18" culvert S 60° E 53.74'
C/L top concrete R.O.W. marker N 20° E 121.30'
C/L "X" of bit road running N-S and gravel road running E-W

P.A. 345 1990 KENT COUNTY

PEER APPROVED 7/29/99
CHAIRMAN Gary Hube

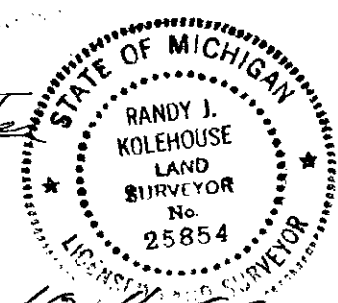

Signed by Randy J. Kolehouse Date 10-11-99
WILLIAMS & WORKS

Surveyor's Michigan License No. 25854