

MAY 22 2000

SECTION LAND CORNER RECORDATION CERTIFICATE Filing Requirement of Act 74, Mich. P.A. 1970 KENT COUNTY REMONUMENTATION

For corners in

Table with columns: Kent (County), Located in: Oakfield Township, Corner Code #. Rows include Public Land Survey, Property Controlling in Section, and Miscellaneous Property in Sec.

REG. OF DEEDS stamp with date 1999 OCT 27 AM 8:38 and file number 11445. Register of Deeds Stamp & File Number.

- 4. Lot No. , Recorded Plat
5. Private Claims


I, Randy Kolehouse, in a field survey on March 16 19 99, do hereby certify that under requirements of P.A. 74 Michigan P.A. of 1970, the corner points mentioned in lines 1 and 2 above were in conformance with regulations and rules therefore as required in the current manual of survey instructions of the United States Department of the Interior, Bureau of Land Management or by a decree of a Court of Law and/or that the corner points mentioned in lines 3, 4 and 5 above were in conformance with the rules of the Michigan Board of Land Surveyors or by a Decree of a Court of Law, established, re-established, monumented, re-monumented, recovered, found as expressed below:

NOTE: Not more than 4 corners, all in the same town and range, may be recorded on this certificate.

A. Description of original monument and accessories and/or subsequent restoration:

Table with columns: I-10, 1837, 1979, 1982, 1994, G.L.O. Notes, L.C.R.C. #1298, #2685, #7223, Cathcart, Glaza & Associates, Jonker Land Surveys, Glaza & Associates, Set Post, Iron in Mon. Box, Fnd. 1/2" Iron - Set K.C. Monument, K.C. Monument.

P.A. 345 1990 KENT COUNTY PEER APPROVED 7/29/99 CHAIRMAN [Signature]

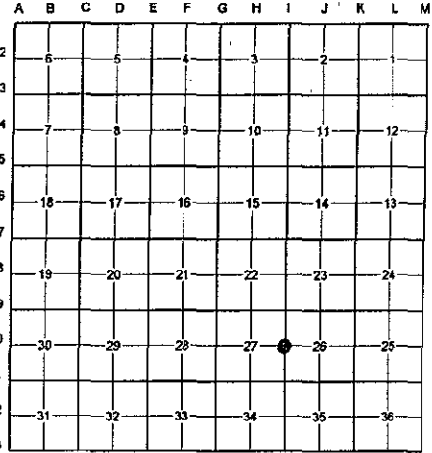

This corner was originally approved by the Kent County Remonumentation Peer Group and monumented by Rob Jonker on 5/5/81 and was recorded per L.C.R.C. #2685.

B. Description of corner evidence found and/or method applied in restoring or reestablishing corner:

I-10 Found a Standard Kent County Monument 2" below grade at the C/L intersection of Lincoln Lake Avenue (bit.) running North and South and Beardslee Street (bit.) running East, on line of a tree row and fence line running West, per L.C.R.C.'s #2685 and #7223 as set by Rob Jonker in place of a 1/2" iron he found in a monument box which checked L.C.R.C. #1298.

L.C.R.C. #2685

L.C.R.C. #7223

N. end of drive culvert S25°W 59.55'
"X" cut on top of curb N45°E 36.00'
"X" cut on top of curb S45°E 36.00'


North end of drive culvert S25°W 59.55' (m. 59.57')
"X" cut on top of curb N45°E 35.98' (m. 36.03')
"X" cut on top of curb S45°E 36.18' (m. 36.15')
K.C. remon tag & nail in S side 12" Hickory N90°W 32.83' (m. 32.85')

The selected location is accepted by me and is generally accepted by professional surveyors as the best available evidence of the position of the original corner.

C. Description of monument for corner and accessories established to perpetuate locating the position of the corner:

I-10 Standard Kent County Monument

North end of drive culvert S 25° W 59.57'
"X" cut top of curb N 45° E 36.03'
"X" cut top of curb S 45° E 36.15'
Nail & K.C. remon. tag on S side 12" Hickory N 90° W 32.85'
Nail & K.C. remon. tag on SW side P. pole S 65° E 78.98'
On C/L "X" of bit. roads running N-S & E
On tree row and fence line running W

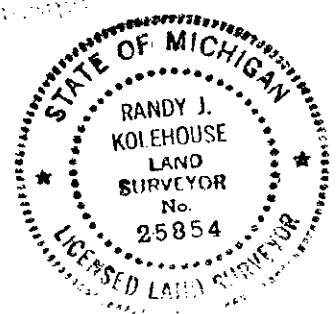

Signed by [Signature] Date 10-11-99

WILLIAMS & WORKS

Surveyor's Michigan License No. 25854