

MAY 22 2000

SECTION

LAND CORNER RECORDATION CERTIFICATE  
Filing Requirement of Act 74, Mich. P.A. 1970  
KENT COUNTY REMONUMENTATION

REG. OF DEEDS

STATE OF MICHIGAN  
COUNTY OF KENT  
RECEIVED FOR RECORD  
1999 OCT 27 AM 8:38


For corners in

Kent (County)	Located in: Oakfield Township	Corner Code #
1. Public Land Survey	T <u>9N</u> R <u>9W</u>	<u>I-11</u>
	T _____ R _____	_____
	T _____ R _____	_____
	T _____ R _____	_____
2. Property Controlling in Section	S _____ T _____ R _____	_____
	S _____ T _____ R _____	_____
3. Miscellaneous Property in Sec.	S _____ T _____ R _____	_____
	S _____ T _____ R _____	_____

11446

Register of Deeds Stamp & File Number

- 4. Lot No. \_\_\_\_\_, Recorded Plat \_\_\_\_\_
- 5. Private Claims \_\_\_\_\_

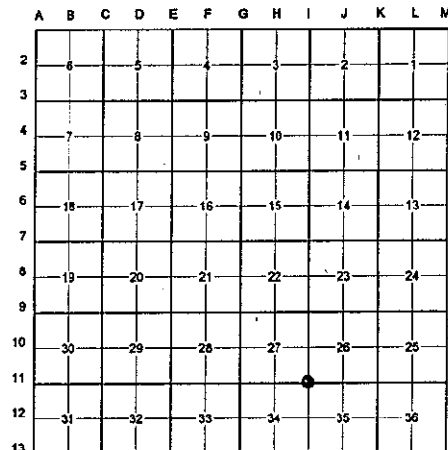

I, Randy Kolehouse, in a field survey on March 16 19 99, do hereby certify that under requirements of P.A. 74 Michigan P.A. of 1970, the corner points mentioned in lines 1 and 2 above were in conformance with regulations and rules therefore as required in the current manual of survey instructions of the United States Department of the Interior, Bureau of Land Management or by a decree of a Court of Law and/or that the corner points mentioned in lines 3, 4 and 5 above were in conformance with the rules of the Michigan Board of Land Surveyors or by a Decree of a Court of Law; established, re-established, monumented, re-monumented, recovered, found as expressed below:

**NOTE: Not more than 4 corners, all in the same town and range, may be recorded on this certificate.**

A. Description of original monument and accessories and/or subsequent restoration:

I-11	1837	G.L.O. Notes	Cathcart	Set Post
	1959	Witness Map	K.C. Surveyor	3/4" Iron
	1978	L.C.R.C. #1159	C.S. Hay	Iron in Box
	1981	L.C.R.C. #1865	Jonker Land Surveys	Fnd. Mon. Box & Iron / Set K.C. Monument
	1994	L.C.R.C. #7224	Glaze & Associates	K.C. Monument

P.A. 345 1990 KENT COUNTY  
PEER APPROVED 7/29/99  
CHAIRMAN Randy Kolehouse

This corner was originally approved by the Kent County Remonumentation Peer Group and monumented by Rob Jonker on 5/29/81 and was recorded per L.C.R.C. #1865.

B. Description of corner evidence found and/or method applied in restoring or reestablishing corner:

I-11 Found a Standard Kent County Monument 2' ± North of the C/L intersection of Lincoln Lake Avenue (bit) running North and South and 11 Mile Road (gravel) running East, on a tree row running West, per L.C.R.C.'s #1865 and #7224 as set by Rob Jonker in place of an iron and a monument box he found which checked L.C.R.C. #1159 and the K.C. Surveyor's records.

L.C.R.C. #1865

L.C.R.C. #7224

Remon. tag on SE side 18" cedar S45°W 48.00  
On C.L. "X" of pavement

K.C. remon tag & nail in SE side 18" Cedar S45°W 47.96' (m. 47.97')  
On C/L "X" of pavement


K.C. remon tag & nail on top of 6" x 8" guard rail post S20°W 50.00'  
"X" cut on top of concrete R.O.W. marker S20°E 111.42' (m. 111.56')

The selected location is accepted by me and is generally accepted by professional surveyors as the best available evidence of the position of the original corner.

C. Description of monument for corner and accessories established to perpetuate locating the position of the corner:

I-11 Standard Kent County Monument

- Nail & K.C. remon. tag on SE side 18" Cedar S 45° W 47.97'
- Nail & K.C. remon. tag on S side 8" Hickory N 70° W 48.27'
- Nail & K.C. remon. tag on top 6" x 8" guard rail post S 20° W 50.00'
- "X" cut top conc. R.O.W. marker S 20° E 111.56'
- "X" cut top conc. R.O.W. marker N 22° E 121.09'
- On C/L of bit. road running N-S
- C/L of gravel road running E, South 2' ±
- On tree row running W

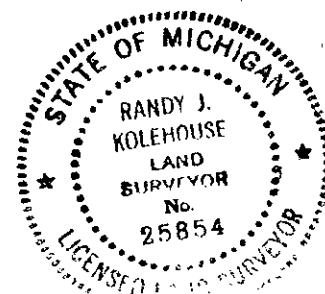

Signed by Randy J. Kolehouse Date 10-11-99

WILLIAMS & WORKS

Surveyor's Michigan License No. 25854