

MAY 22 2000

LAND CORNER RECORDATION CERTIFICATE
Filing Requirement of Act 74, Mich. P.A. 1970
KENT COUNTY REMONUMENTATION

For corners in

SECTION

Table with columns: Kent (County), Located in: Oakfield Township, Corner Code #. Rows include Public Land Survey, Property Controlling In Section, Miscellaneous Property in Sec.

REG. OF DEEDS

STATE OF MICHIGAN
COUNTY OF KENT
RECEIVED FOR RECORD
1999 OCT 27 AM 8:39

11447

Register of Deeds Stamp & File Number

- 4. Lot No. Recorded Plat
5. Private Claims

I, Randy Kolehouse, in a field survey on March 23 19 99, do hereby certify that under requirements of P.A. 74 Michigan P.A. of 1970, the corner points mentioned in lines 1 and 2 above were in conformance with regulations and rules therefore as required in the current manual of survey instructions of the United States Department of the interior, Bureau of Land Management or by a decree of a Court of Law and/or that the corner points mentioned in lines 3, 4 and 5 above were in conformance with the rules of the Michigan Board of Land Surveyors or by a Decree of a Court of Law; established, re-established, monumented, re-monumented, recovered, found as expressed below:

NOTE: Not more than 4 corners, all in the same town and range, may be recorded on this certificate.

A: Description of original monument and accessories and/or subsequent restoration:

Table with 4 columns: Corner Code, Date, Description, Monument Type. Includes entries for 1837, 1978, 1986, 1994.

This corner was originally approved by the Kent County Remonumentation Peer Group and monumented by Randy Kolehouse on 2/2/85 and was recorded per L.C.R.C. #1159.

B. Description of corner evidence found and/or method applied in restoring or reestablishing corner:

I-12 Found a Standard Kent County Monument 70' +/- West of the C/L of Lincoln Lake Avenue (bit.) running North and South and 13' +/- South of a fence line running West per L.C.R.C.'s #4364 and #7225 as set by Randy Kolehouse in place of a concrete monument he found which checked L.C.R.C. #1159 and the K.C. Surveyor's records.

L.C.R.C. #4364

L.C.R.C. #7225

Nail in N. Side 16" Oak N 80° W 49.65'
SE cor Frame Hse. N 25° W 63.0'
NE cor Frame Hse. S 85° W 52.15'
SE cor Frame Hse. S 45° W 61.18'
2" steel fe. post N 35° W 13.0'

Nail in N side 20" Oak N80°W 49.71' (m. 49.69')
SE corner of frame house (foundation) N25°W 63.57' (m. 63.55')
NE corner of frame house S85°W 52.09' (m. 52.08')
SE corner of frame house S45°W 61.04' (m. 61.02')
2" steel fence post N35°W 13.00'
K.C. remon tag & nail in E side 20" Oak S22°W 53.18' (m. 53.16')


The selected location is accepted by me and is generally accepted by professional surveyors as the best available evidence of the position of the original corner.

C. Description of monument for corner and accessories established to perpetuate locating the position of the corner:

I-12 Standard Kent County Monument

Nail & K.C. remon. tag on N side 24" Oak N 80° W 49.67'
Nail & K.C. remon. tag on E side 26" Oak S 22° W 53.16'
SE cor. fndn. (hse. #8807) N 25° W 63.55'
NE cor. frame hse. #8795 S 85° W 52.08'
SE cor. frame hse. #8795 S 45° W 61.02'
2" steel fence post N 35° W 13.00'
C/L of bit. road running N-S, East 70' +/-
Fence line running W, North 13' +/-

P.A. 345 1990 KENT COUNTY
PEER APPROVED 7/29/99
CHAIRMAN

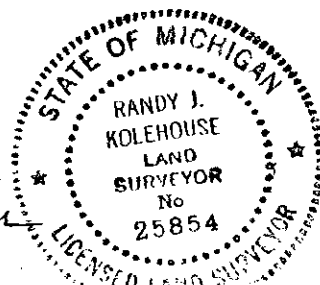

Signed by Randy J. Kolehouse Date 10-11-99

WILLIAMS & WORKS

Surveyor's Michigan License No. 25854