

SURVEY & REMONUMENTATION

\$7.00
\$2.00

MAR 08 1999

LAND CORNER RECORDATION CERTIFICATE
Filing Requirement of Act 74, Mich. P.A. 1970
KENT COUNTY REMONUMENTATION

For corners in

SECTION

Kent (County)	Located in:	Oakfield Township	Corner Code #
1. Public Land Survey	T <u>9N</u>	R <u>9W</u>	<u>I-13</u>
	T _____	R _____	_____
	T _____	R _____	_____
	T _____	R _____	_____
2. Property Controlling in Section	S _____	T _____	R _____
	S _____	T _____	R _____
3. Miscellaneous Property in Sec.	S _____	T _____	R _____
	S _____	T _____	R _____

REG. OF DEEDS

Handwritten signature

98 DEC 14 AM 8:00

STATE OF MICHIGAN
COUNTY OF KENT
RECEIVED FOR RECORD

10958

Register of Deeds Stamp & File Number

4. Lot No. _____, Recorded Plat _____
5. Private Claims _____

I, Randy Kolehouse, in a field survey on January 30 19 98, do hereby certify that under requirements of P.A. 74 Michigan P.A. of 1970, the corner points mentioned in lines 1 and 2 above were in conformance with regulations and rules therefore as required in the current manual of survey instructions of the United States Department of the interior, Bureau of Land Management or by a decree of a Court of Law and/or that the corner points mentioned in lines 3, 4 and 5 above were in conformance with the rules of the Michigan Board of Land Surveyors or by a Decree of a Court of Law; established, re-established, monumented, re-monumented, recovered, found as expressed below:

	A	B	C	D	E	F	G	H	I	J	K	L	M
2	6	5	4	3	2	1							
3													
4	7	8	9	10	11	12							
5													
6	18	17	16	15	14	13							
7													
8	19	20	21	22	23	24							
9													
10	30	29	28	27	26	25							
11													
12	31	32	33	34	35	36							
13													

NOTE: Not more than 4 corners, all in the same town and range, may be recorded on this certificate.

A. Description of original monument and accessories and/or subsequent restoration:

I-13	1837	G.L.O. Notes	N. Brookfield	Set Post
	1887-1971	Notes	Williams & Works	Set Stone - Replaced by Iron - Concrete Mon.
	1925	Witness Map	K.C. Surveyor	Stone
	1985	L.C.R.C. #4117	William Byl	Fnd. Concrete Monument / Set K.C. Monument
	1994	L.C.R.C. #7226	Glaza & Associates	K.C. Monument

Note: This corner is not common with I-1, T8N, R9W.

This corner was originally approved by the Kent County Remonumentation Peer Group and monumented by William Byl and William Byl and was recorded per L.C.R.C. #4117.

B. Description of corner evidence found and/or method applied in restoring or reestablishing corner:

I-13 Found a Standard Kent County Monument 4' North of a fence line running East and 130' ± East of the C/L of Lincoln Lake Avenue (bit.) running North and South per L.C.R.C.'s #4117 and #7226 as set by William Byl in place of a concrete monument he found which checked the 1887-1971 notes of Williams & Works and the K.C. Surveyor's records

L.C.R.C. #4117

L.C.R.C. #7226

Nail & tag, N sd. 24" Hickory N 85 E 13.73'
Nail & tag, E sd. 36" Oak S 00 W 15.97'
Nail & tag, N sd. 48" Oak S 70 W 35.55'

Nail & K.C. remon tag in N side 24" Hickory N85°E 13.73'
Nail & K.C. remon tag in E side 36" Oak S00°W 15.97'
Nail & K.C. remon tag in N side 48" Oak S70°W 35.48'
Old East-West fence line South 4'+/-
Harrison Monument (NW cor, Sec 2, 8-9) West 136.86'

The selected location is accepted by me and is generally accepted by professional surveyors as the best available evidence of the position of the original corner.


C. Description of monument for corner and accessories established to perpetuate locating the position of the corner:

I-13 Standard Kent County Monument

Nail & K.C. remon. tag on N side 24" Hickory N 85° E 13.73'
Nail & K.C. remon. tag on E side 36" Oak S 00° W 15.97'
Nail & K.C. remon. tag on N side 48" Oak S 70° W 35.48'
Nail & K.C. remon. tag on W side 12" Hickory S 40° E 23.17'
Fence line running E, South 4'
C/L of bit. road running N-S, West 130' ±
K.C. Mon., I-1, T8N, R9W, West 136.86'

P.A. 345 1990 KENT COUNTY

PEER APPROVED 9/24/98
CHAIRMAN Randy Kolehouse

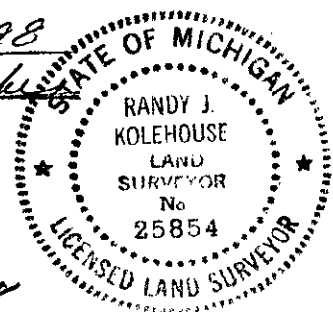

Signed by Randy J. Kolehouse
EARTH TECH

Date 11/18/98

Surveyor's Michigan License No. 25854